


**CERTIFIED RECORD OF LAND CORNER MONUMENTATION**

**HISTORY OF ORIGINAL CORNER ESTABLISHED:**

Corner originally established by David Thompson and Daniel Chaplin under GLO Contract Number 104, dated April 16th, 1864. Surveyor General Field Notes state:

Set post for cor. to secs. 13, 14, 23, & 24, in mound of earth with charred stake, pits, trench, as per instructions.

T 7 S R 39 E N-21

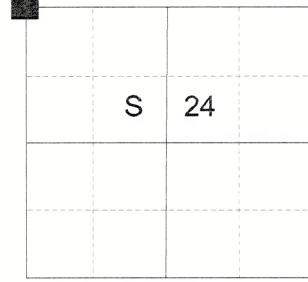

**DESCRIPTION OF CORNER EVIDENCE FOUND:**


Found embedded remnants of a North/South barb wire fence approx. 18" below ground in a cultivated field.

**DESCRIPTION OF MONUMENT AND ACCESSORIES I ESTABLISHED TO MONUMENT THE ORIGINAL LOCATION OF THIS CORNER:**

At Easting of found fence and Northing by proportionate measure, I set a 2 1/2" x 30" aluminum pipe, 30" in the ground, with 3" aluminum cap marked as shown below, from which:

**NEW BEARING OBJECTS:**

- A 5/8" x 30" iron pin bears North 25°33' East, a distance of 24.64 feet with 1 1/2" aluminum cap marked NE RP BGB SURVEY MARKER.
- A 5/8" x 30" iron pin bears South 25°11' East, a distance of 26.45 feet with 1 1/2" aluminum cap marked SE RP BGB SURVEY MARKER.
- A 5/8" x 30" iron pin bears South 37°24' West, a distance of 18.85 feet with 1 1/2" aluminum cap marked SW RP BGB SURVEY MARKER.
- A 5/8" x 30" iron pin bears North 47°36' West, a distance of 16.43 feet with 1 1/2" aluminum cap marked NW RP BGB SURVEY MARKER.

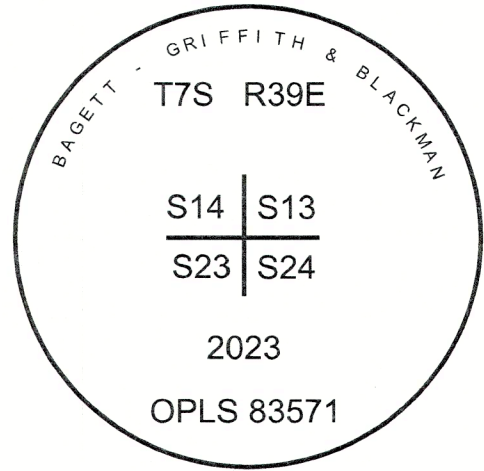

Set steel fence post approx. 0.6 feet West.

falls in cultivated field approx. 10 feet West of draw bottom.

I hereby certify that the corner was monumented on June 13, 2023.  
Witness: Kyle Tucker



I used a Leica GS18 with RTK in the establishment of the new accessories. Bearings and distances are measured to the center of the aluminum caps. Basis of bearing is as per Survey for Brad Allen filed concurrently.

Renewal Date: June 30, 2025

N-21

FILED July 19, 2023  
BAKER COUNTY SURVEYOR  
SURVEY NO. 7-39-127