


CERTIFIED RECORD OF LAND CORNER MONUMENTATION

HISTORY OF ORIGINAL CORNER ESTABLISHED:

In Survey 7-39-7, filed 1976, Hanley set a 5/8" rebar at true position.

T 7 S R 39 E N-24

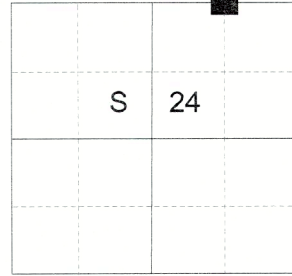

DESCRIPTION OF CORNER EVIDENCE FOUND:

Found a 5/8" x 30" iron pin uprooted and bent. Original position indeterminate.

DESCRIPTION OF MONUMENT AND ACCESSORIES I ESTABLISHED TO MONUMENT THE ORIGINAL LOCATION OF THIS CORNER:

At position by Survey, I set a 5/8" x 30" iron pin, 26" in the ground, with 2 1/2" aluminum cap marked as shown below in a 2 foot collar of stone, from which:

NEW BEARING OBJECTS:

A 5/8" x 15" iron pin bears South 47°15' West, a distance of 23.27 feet with 1 1/2" aluminum cap marked S RP BGB SURVEY MARKER.

A 5/8" x 15" iron pin bears North 57°13' West, a distance of 17.08 feet with 1 1/2" aluminum cap marked N RP BGB SURVEY MARKER.


Buried pin alongside.

Set steel fence post approx. 0.5 feet West.

Falls approx. 12 feet South of fence corner to South/West bearing fence lines.

I hereby certify that the corner was monumented on June 8, 2023.

Witness: Kyle Tucker

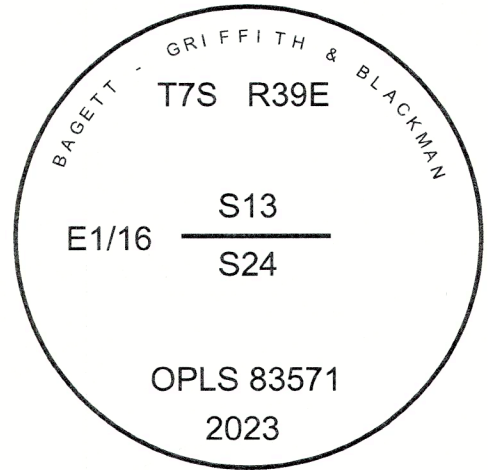

Renewal Date: June 30, 2025

I used a Leica GS18 with RTK in the establishment of the new accessories. Bearings and distances are measured to the center of the aluminum caps. Basis of bearing is as per Survey for Brad Allen filed concurrently.

N-24

FILED July 19, 2023
BAKER COUNTY SURVEYOR
SURVEY NO. 7-39-129