


CERTIFIED RECORD OF LAND CORNER MONUMENTATION

**HISTORY OF ORIGINAL CORNER ESTABLISHED:**

Not previously established

T 7 S R 39 E O-21

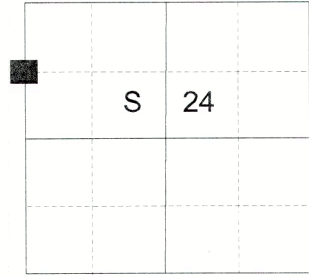

**DESCRIPTION OF CORNER EVIDENCE FOUND:**

None.

**DESCRIPTION OF MONUMENT AND ACCESSORIES I ESTABLISHED TO MONUMENT THE ORIGINAL LOCATION OF THIS CORNER:**

At position by Survey, I set a 5/8" x 30" iron pin, 29" in the ground, with 2 1/2" aluminum cap marked as shown below, from which:

**NEW BEARING OBJECTS:**

A 5/8" x 15" iron pin bears North 88°05' East, a distance of 18.68 feet with 1 1/2" aluminum cap marked N RP BGB SURVEY MARKER.


A 5/8" x 15" iron pin bears South 5°38' East, a distance of 23.48 feet with 1 1/2" aluminum cap marked S RP BGB SURVEY MARKER.

Set steel fence post approx. 0.3 feet Northwesterly.

Falls approx. 2 feet West of fence corner to South/East bearing fence lines.

I hereby certify that the corner was monumented on June 13, 2023.

Witness: Kyle Tucker

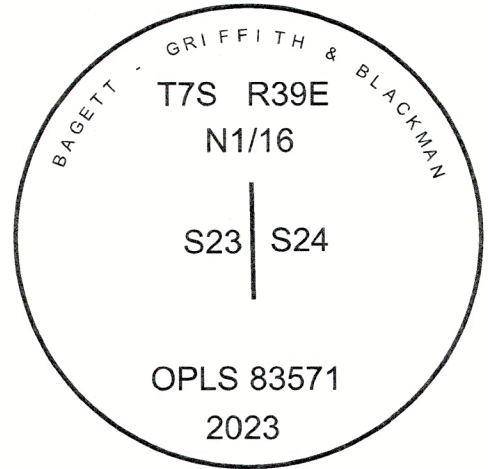

Renewal Date: June 30, 2025

I used a Leica GS18 with RTK in the establishment of the new accessories. Bearings and distances are measured to the center of the aluminum caps. Basis of bearing is as per Survey for Brad Allen filed concurrently.

O-21

FILED July 19, 2023  
BAKER COUNTY SURVEYOR  
SURVEY NO. 7-39-131