

CERTIFIED RECORD OF LAND CORNER MONUMENTATION


HISTORY OF ORIGINAL CORNER ESTABLISHED:

Corner originally established by David Thompson and Daniel Chaplin under GLO Contract Number 104, dated April 16th, 1864. Surveyor General Field Notes state:

Set post for 1/4 sec. cor. in mound of earth with charred stake, pits, trench, as per instructions.

In 1919 Ira Hoffman found a stone. Ira Hoffman Surey Book 34, Page 6 states:
39.63 chs. to fence + 63 lks N. to a stone. At 40.15 chs. +8 lks. West set a stake.

T 7 S R 39 E P-13

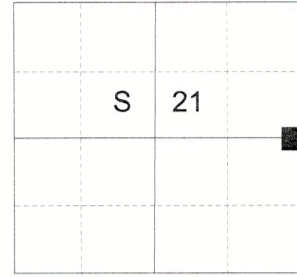

DESCRIPTION OF CORNER EVIDENCE FOUND:


Found an East/West fence line approx. 40 feet South of proportionate position. No stone found in the area.

DESCRIPTION OF MONUMENT AND ACCESSORIES I ESTABLISHED TO MONUMENT THE ORIGINAL LOCATION OF THIS CORNER:

At position determined by Survey, I set a 2 1/2" x 30" aluminum pipe, 29" in the ground, with 3" aluminum cap marked as shown below, from which:

NEW BEARING OBJECTS:

- A 5/8" x 15" iron pin bears North 51°23' East, a distance of 28.91 feet with 1 1/2" aluminum cap marked NE RP BGB SURVEY MARKER.
- A 5/8" x 15" iron pin bears South 46°29' East, a distance of 47.45 feet with 1 1/2" aluminum cap marked SE RP BGB SURVEY MARKER.
- A 5/8" x 15" iron pin bears South 46°01' West, a distance of 50.29 feet with 1 1/2" aluminum cap marked SW RP BGB SURVEY MARKER.
- A 5/8" x 15" iron pin bears North 61°17' West, a distance of 30.67 feet with 1 1/2" aluminum cap marked NW RP BGB SURVEY MARKER.

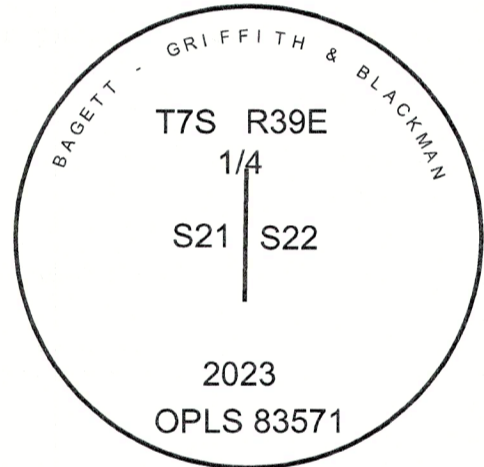

I hereby certify that the corner was monumented on May 23, 2023.
Witness: Kyle Tucker



Renewal Date: June 30, 2025

I used a Leica GS18 with RTK in the establishment of the new accessories. Bearings and distances are measured to the center of the aluminum caps. Basis of bearing is as per Survey, filed concurrently.

P-13

FILED July 19, 2023
BAKER COUNTY SURVEYOR
SURVEY NO. 7-39-133