

CERTIFIED RECORD OF LAND CORNER MONUMENTATION


HISTORY OF ORIGINAL CORNER ESTABLISHED:

Corner originally established by David Thompson and Daniel Chaplin under GLO Contract Number 104, dated April 16th, 1864. Surveyor General Field Notes state:

Set post for cor. to secs. 21, 22, 27, 28, in mound of earth with charred stake, pits, trench, as per instructions.

In 1919 Ira Hoffman finds a stone. Book 34, Page 6 of the Hoffman notes states: cor. to secs 21, 22, 27, + 28 marked with a granite stone parts of government willow post, found stone not marked.

T 7 S R 39 E R-13

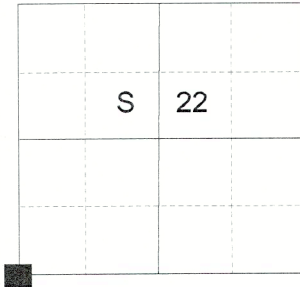

DESCRIPTION OF CORNER EVIDENCE FOUND:


Found 19" x 14" x 6" granite stone faintly marked "28". The stone is very crumbly and appears to have had other marks but they are indiscernible. Upon excavation below the said stone I find a 28" x 10" x 10" pillar like stone firmly planted with no marks.

DESCRIPTION OF MONUMENT AND ACCESSORIES I ESTABLISHED TO MONUMENT THE ORIGINAL LOCATION OF THIS CORNER:

At position of found stone, I set a 2 1/2" x 30" aluminum pipe, 29" in the ground, with 3" aluminum cap marked as shown below and in a 2 foot diameter collar of stone, from which:

NEW BEARING OBJECTS:

- A 5/8" x 15" iron pin bears North 49°45' East, a distance of 15.70 feet with 1 1/2" aluminum cap marked NE RP BGB SURVEY MARKER.
- A 5/8" x 15" iron pin bears South 56°09' East, a distance of 10.95 feet with 1 1/2" aluminum cap marked SE RP BGB SURVEY MARKER.
- A 5/8" x 15" iron pin bears South 59°26' West, a distance of 12.10 feet with 1 1/2" aluminum cap marked SW RP BGB SURVEY MARKER.
- A 5/8" x 15" iron pin bears North 50°01' West, a distance of 13.86 feet.

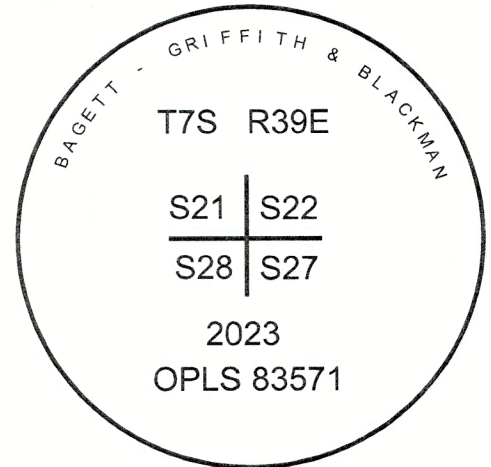

Buried marked stone on the South and set pillar stone 6" above ground approx. 0.3 feet North

Falls approx. 5 feet North of East/West bearing fence line

I hereby certify that the corner was monumented on June 2, 2023.
Witness: Kyle Tucker

REGISTERED
PROFESSIONAL
LAND SURVEYOR



OREGON
June 2, 2010
JEFFREY S. HSU
83571

Renewal Date: June 30, 2025

I used a Leica GS18 with RTK in the establishment of the new accessories. Bearings and distances are measured to the center of the aluminum caps or bare iron pin. Basis of bearing is as per Survey for Brad Allen filed concurrently.

R-13

FILED July 19, 2023
BAKER COUNTY SURVEYOR
SURVEY NO. 7-39-136