

CERTIFIED RECORD OF LAND CORNER MONUMENTATION


HISTORY OF ORIGINAL CORNER ESTABLISHED:

Corner originally established by David Thompson and Daniel Chaplin, under GLO Contract Number 104, dated April 16, 1864. Surveyor General Field Notes state:

Set post for 1/4 sec. cor. in mound of earth with charred stake, pits, trench, as per instructions.

In Survey 7-39-4, dated 1975, Hanley holds a fence corner as the quarter corner.

T 7 S R 39 E R-15

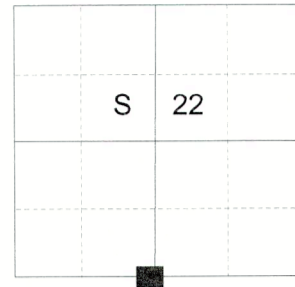

DESCRIPTION OF CORNER EVIDENCE FOUND:

Found a fence corner to East and South bearing fence lines that matches distance from other found monuments in the area and noted on said Hanley Survey.

DESCRIPTION OF MONUMENT AND ACCESSORIES I ESTABLISHED TO MONUMENT THE ORIGINAL LOCATION OF THIS CORNER:

At Northwest edge of found fence corner, I set a 2 1/2" x 30" aluminum pipe, 27" in the ground, with 3" aluminum cap marked as shown below, from which:

NEW BEARING OBJECTS:

A 5/8" x 15" iron pin bears North 45°50' East, a distance of 19.37 feet with 1 1/2" aluminum cap marked NE RP BGB SURVEY MARKER.


A 5/8" x 15" iron pin bears South 40°01' East, a distance of 12.03 feet with 1 1/2" aluminum cap marked SE RP BGB SURVEY MARKER.

A 5/8" x 15" iron pin bears South 36°53' West, a distance of 27.14 feet with 1 1/2" aluminum cap marked SW RP BGB SURVEY MARKER.

A 5/8" x 15" iron pin bears North 65°11' West, a distance of 17.73 feet with 1 1/2" aluminum cap marked NW RP BGB SURVEY MARKER.

Falls approx. 70 feet North of fence corner to North/South/West bearing fence lines.

I hereby certify that the corner was monumented on June 2, 2023.
Witness: Kyle Tucker

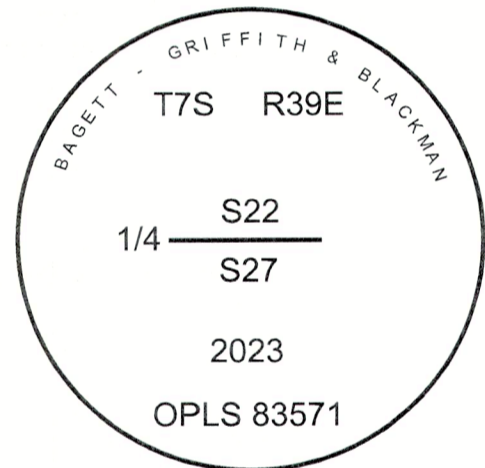

Renewal Date: June 30, 2025

I used a Leica GS18 with RTK in the establishment of the new accessories. Bearings and distances are measured to the center of the aluminum caps. Basis of bearing is as per Survey for Brad Allen filed concurrently.

R-15

FILED July 19, 2023
BAKER COUNTY SURVEYOR
SURVEY NO. 7-39-137