


CERTIFIED RECORD OF LAND CORNER MONUMENTATION

HISTORY OF ORIGINAL CORNER ESTABLISHED:

Corner originally established by David Thompson and Daniel Chaplin, under GLO Contract Number 104, dated April 16, 1864. Surveyor General Field Notes state:

Set post for 1/4 sec. cor. in mound of earth with charred stake, pits, trench, as per instructions.

T 7 S R 39 E R-23

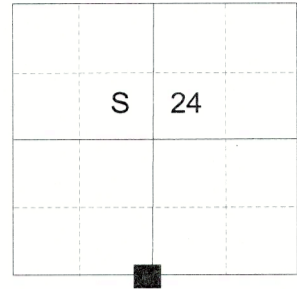

DESCRIPTION OF CORNER EVIDENCE FOUND:


Found a 12" x 7" x 6" stone marked with 1/4 facing North and on the North edge of a 3 foot diam. embedded collar of stones.

DESCRIPTION OF MONUMENT AND ACCESSORIES I ESTABLISHED TO MONUMENT THE ORIGINAL LOCATION OF THIS CORNER:

At position of found stone, I set a 2 1/2" x 30" aluminum pipe, 28" in the ground, with 3" aluminum cap marked as shown below and in a 2 foot diam. collar of stone, from which:

NEW BEARING OBJECTS:

- A 5/8" x 15" iron pin bears North 60°32' East, a distance of 19.48 feet with 1 1/2" aluminum cap marked NE RP BGB SURVEY MARKER.
- A 5/8" x 15" iron pin bears South 31°15' East, a distance of 24.50 feet with 1 1/2" aluminum cap marked SE RP BGB SURVEY MARKER.
- A 5/8" x 15" iron pin bears South 43°18' West, a distance of 20.33 feet with 1 1/2" aluminum cap marked SW RP BGB SURVEY MARKER.
- A 5/8" x 15" iron pin bears North 51°19' West, a distance of 16.81 feet with 1 1/2" aluminum cap marked NW RP BGB SURVEY MARKER.

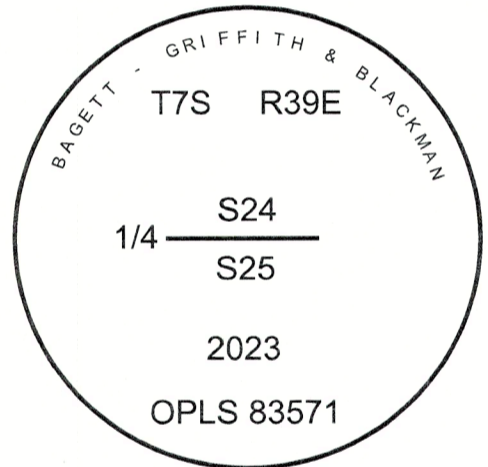

Set steel fence post approx. 1 foot East.

Buried stone alongside.

I hereby certify that the corner was monumented on June 13, 2023.

Witness: Kyle Tucker

REGISTERED
PROFESSIONAL
LAND SURVEYOR



OREGON
June 2, 2010
JEFFREY S. HSU
83571

Renewal Date: June 30, 2025

I used a Leica GS18 with RTK in the establishment of the new accessories. Bearings and distances are measured to the center of the aluminum caps. Basis of bearing is as per Survey for Brad Allen filed concurrently.

R-23

FILED July 19, 2023
BAKER COUNTY SURVEYOR
SURVEY NO. 7-39-138