

CERTIFIED RECORD OF LAND CORNER MONUMENTATION

HISTORY OF ORIGINAL CORNER ESTABLISHED:


Corner originally established by Timothy Davenport under GLO Contract Number 102, dated July 20th, 1863. Surveyor General Field Notes state:

Set post corner to secs. 18, 19, 13, + 24, made mound of earth depositing charred stake as per inst.

David Thompson and Daniel Chaplin, under GLO Contract Number 104, dated April 16, 1864, recover corner to subdivide Township 7 South, Range 39 East of the Willamette Meridian.

In Survey 7-39-7, filed 1976, Hanley found a 5/8" rebar in a mound of stones.

T 7 S R 39 E N-25

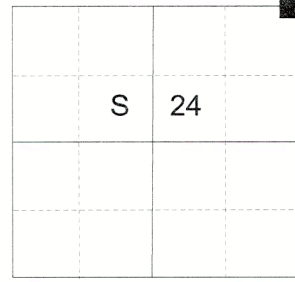

DESCRIPTION OF CORNER EVIDENCE FOUND:

None. A cultivated field and multiple underground irrigation lines occupy the computed position.

DESCRIPTION OF MONUMENT AND ACCESSORIES I ESTABLISHED TO MONUMENT THE ORIGINAL LOCATION OF THIS CORNER:


At distance/distance intersect position from monuments set by said Survey 7-39-7, I set a 2 1/2" x 30" aluminum pipe, 28" in the ground, with 3" aluminum cap marked as shown below and in a 1 foot diam. collar of stone, from which:

NEW BEARING OBJECTS:

- A 5/8" x 15" iron pin bears North 44°26' East, a distance of 14.95 feet with 1 1/2" aluminum cap marked NE RP BGB SURVEY MARKER.
- A 5/8" x 15" iron pin bears South 32°36' East, a distance of 27.41 feet with 1 1/2" aluminum cap marked SE RP BGB SURVEY MARKER.
- A 5/8" x 15" iron pin bears South 38°14' West, a distance of 42.77 feet with 1 1/2" aluminum cap marked SW RP BGB SURVEY MARKER.
- A 5/8" x 15" iron pin bears North 66°59' West, a distance of 30.64 feet with 1 1/2" aluminum cap marked NW RP BGB SURVEY MARKER.

Set steel fence post approx. 0.5 feet South.

I hereby certify that the corner was monumented on June 13, 2023.
Witness: Kyle Tucker

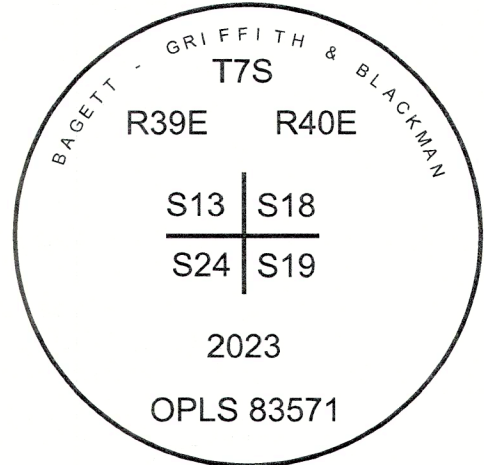

Renewal Date: June 30, 2025

I used a Leica GS18 with RTK in the establishment of the new accessories. Bearings and distances are measured to the center of the aluminum caps. Basis of bearing is as per Survey filed concurrently.

N-25 FILED July 19, 2023
BAKER COUNTY SURVEYOR
SURVEY NO. 7-39-130
7-40-25