

CERTIFIED RECORD OF LAND CORNER MONUMENTATION


HISTORY OF ORIGINAL CORNER ESTABLISHMENT:

Corner originally established May of 1864 by David P. Thompson and Daniel Chaplin in Contract No. 104, dated April 16, 1964. Field note record states:

"Set post for corner to secs 7, 8, 17 & 18 in mound of earth with charred stake. Pits trenched as per instructions"

Corner reestablished by Baker County Surveyor, Ira L. Hoffman, on April 17, 1915. Field Notebook 24, page 72 states:

"I set a basalt stone 6x10x18, 14" in the ground marked with 4 bars on the South and 5 bars on the East"

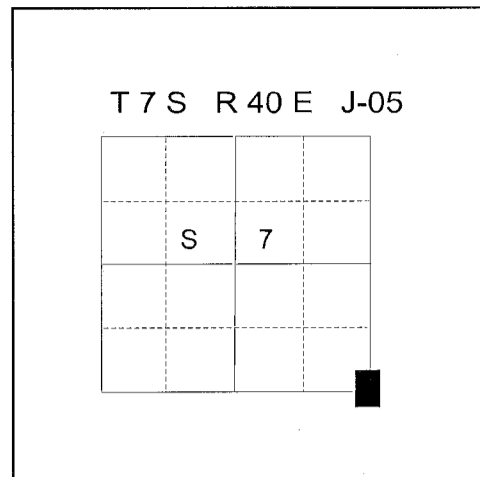

DESCRIPTION OF CORNER EVIDENCE FOUND:

Found stone, 6"x10"x20" with 4 notches on South and 5 notches on East, set in mound of stone 2 ft. diameter.

DESCRIPTION OF MONUMENT AND ACCESSORIES I ESTABLISHED

TO PERPETUATE THE ORIGINAL LOCATION OF THIS CORNER:

At the position of found stone, I set a 1"x30" iron pipe with 2" brass cap marked as shown, 24 inches in the ground, in mound of stone 2' wide, from which;

NEW BEARING OBJECT:

A 5/8" x 30" iron pin bears North 48° East, a distance of 18.82 feet with 1 1/2" aluminum cap marked NE RP.

A 5/8" x 30" iron pin bears South 61° East, a distance of 19.84 feet with 1 1/2" aluminum cap marked SE RP.

A 5/8" x 30" iron pin bears South 40° West, a distance of 21.28 feet with 1 1/2" aluminum cap marked SW RP.


A 5/8" x 30" iron pin bears North 78° West, a distance of 18.13 feet with 1 1/2" aluminum cap marked NW RP.

Original stone buried alongside South side of pipe.
I hereby certify that the corner was set March 27, 2009
Witnesses: Greg T. Blackman Jr. & Jeff Hsu

REGISTERED
PROFESSIONAL
LAND SURVEYOR

OREGON
July 17, 1986
RICK G. ROBINSON
2219

Renewal Date: December 31, 2010

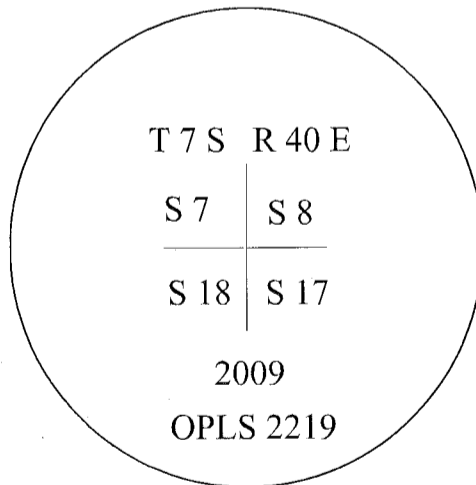

I used a steel tape and magnetic compass in the establishment of the new accessories. I used 18° East declination, the distances are to a center of the aluminum cap.

J-05

FILED Apr. 1, 2009
BAKER COUNTY SURVEYOR
SURVEY NO. 7-40-11
CP # 130