

**CERTIFIED RECORD OF LAND CORNER MONUMENTATION**


**HISTORY OF ORIGINAL CORNER ESTABLISHMENT:**

Corner originally established by County Surveyor Ira Hoffman in 1915. Survey Book 24, page 89 states:

Set a basalt stone 6x16x18, 15 in the ground, marked 1/16 on N. face.

**DESCRIPTION OF CORNER EVIDENCE FOUND:**

Found stone 6x16x18, marked "1/16" on North face.

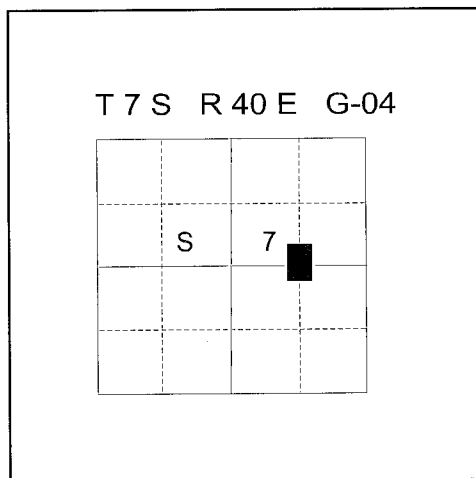

**DESCRIPTION OF MONUMENT AND ACCESSORIES I ESTABLISHED**

**TO PERPETUATE THE ORIGINAL LOCATION OF THIS CORNER:**

At the position of the found stone, I set a 5/8"x 30" iron pin with 2 1/2" aluminum cap marked as shown, 30 inches in the ground, from which;

**NEW BEARING OBJECTS:**

A 5/8" x 30" iron pin bears South 8°13'34" East, a distance of 12.62 feet, with 1 1/2" aluminum cap marked "S RP"

A 5/8" x 30" iron pin bears South 82°25'51" West, a distance of 15.53 feet, with 1 1/2" aluminum cap marked "W RP"


I bury the original stone along the West side of the monument. Corner falls on the North side of an existing fence corner, fencelines run East/West and South.

I hereby certify that the corner was monumented on April 13, 2011.

REGISTERED  
PROFESSIONAL  
LAND SURVEYOR

*Jeffery S. Hsu*  
OREGON  
June 2, 2010  
JEFFERY S. HSU  
83571

Renewal Date: June 30, 2013

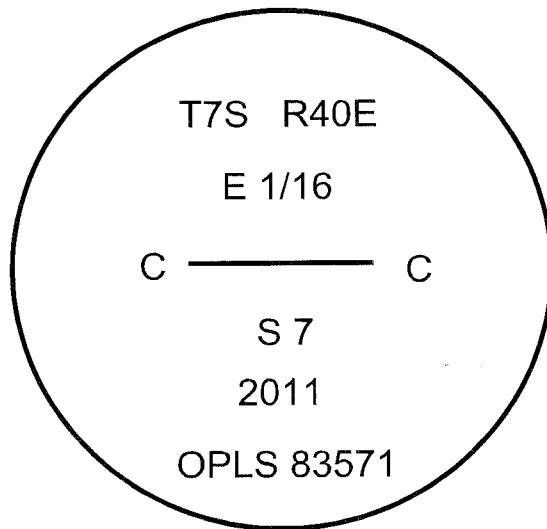

I used a Leica 1200 RTK GPS in the establishment of the accessories. Basis of bearings is a solar observation taken at a point 3550 feet South and 3360 feet West of the Northeast corner of Section 22, Township 6 South, Range 39 East of the Willamette Meridian. Bearings and distances are to the center of the aluminum cap accessories.

G-04

FILED Dec. 5, 2011  
BAKER COUNTY SURVEYOR  
SURVEY NO. 7-40-14