



SE 1/4 SEC. 33, T. 7 S., R. 40 E., W.M.
 SW 1/4 SEC. 33, T. 7 S., R. 40 E., W.M.

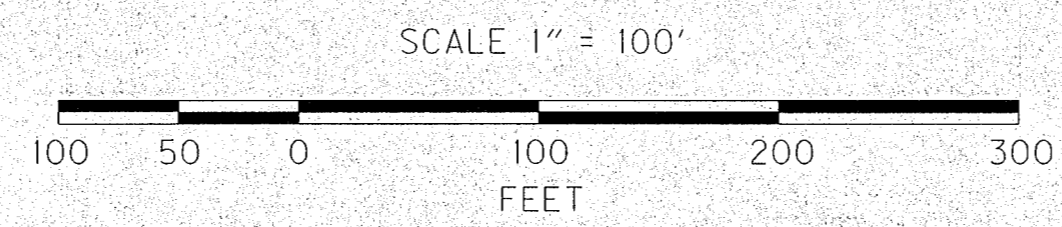

S. 2°27'54" E.
 (S. 2°27'30" E.)
 OLD OREGON TRAIL HIGHWAY (I-84)

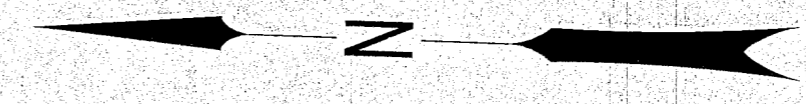

LEGEND	
○	FOUND MONUMENT
★	SET GPS STATION PER TABLE ON SHEET 1
()	RECORD DATA (PER ODOT DRG. 9B-3-2)
—	RESOLVED RIGHT OF WAY
—	EXISTING RIGHT OF WAY OR PROPERTY LINE
—	PRIMARY HIGHWAY RIGHT OF WAY CENTER LINE ALIGNMENT

RECOVERED MONUMENT LIST

PT ID	PROJECT NORTHING	PROJECT EASTING	STATION	OFFSET	DESCRIPTION & REFERENCE DOCUMENTS
RW_07	463279.57	8898830.56	1734+61.83	200.09' LT	FOUND 5/8" IRON ROD, ODOT DRG. 9B-3-21
RW_08	463741.56	8898810.58	1729+99.40	200.00' LT	FOUND 5/8" IRON ROD W/ ALUM. CAP MARKED "OREG STATE HWY DEPT", ODOT DRG. 9B-3-21
RW_09	465034.67	8898754.92	1717+05.09	200.00' LT	FOUND 5/8" IRON ROD W/ ALUM. CAP MARKED "OREG STATE HWY DEPT", ODOT DRG. 9B-3-21
CULLEY_NE	463240.31	8901267.17	N/A	N/A	FOUND 1" DIAMETER SQUARE BOLT, DOWN 8", UNKNOWN ORIGIN

REGISTERED PROFESSIONAL LAND SURVEYOR

BRET N. ELITHORP
 OREGON
 JAN. 14, 2003
 63148

RENEWAL: DEC. 31, 2017

OREGON DEPARTMENT OF TRANSPORTATION
 HORIZONTAL CONTROL, RECOVERY AND RETRACEMENT MAP
 184: WB SNOW FENCE @ CULLEY LANE PHASE 2 - AREA 2
 OLD OREGON TRAIL HIGHWAY (I-84)
 BAKER COUNTY
 FILED June 14 2016
 BAKER COUNTY SURVEYOR
 SURVEY NO. 7-40-17
 8-40-41
 FOR ODOT REGION 5
 3012 ISLAND AVENUE
 LA GRANDE, OR 97850
 MARCH 15, 2016
 SCALE: 1" = 100'
 SHEET 2 OF 5