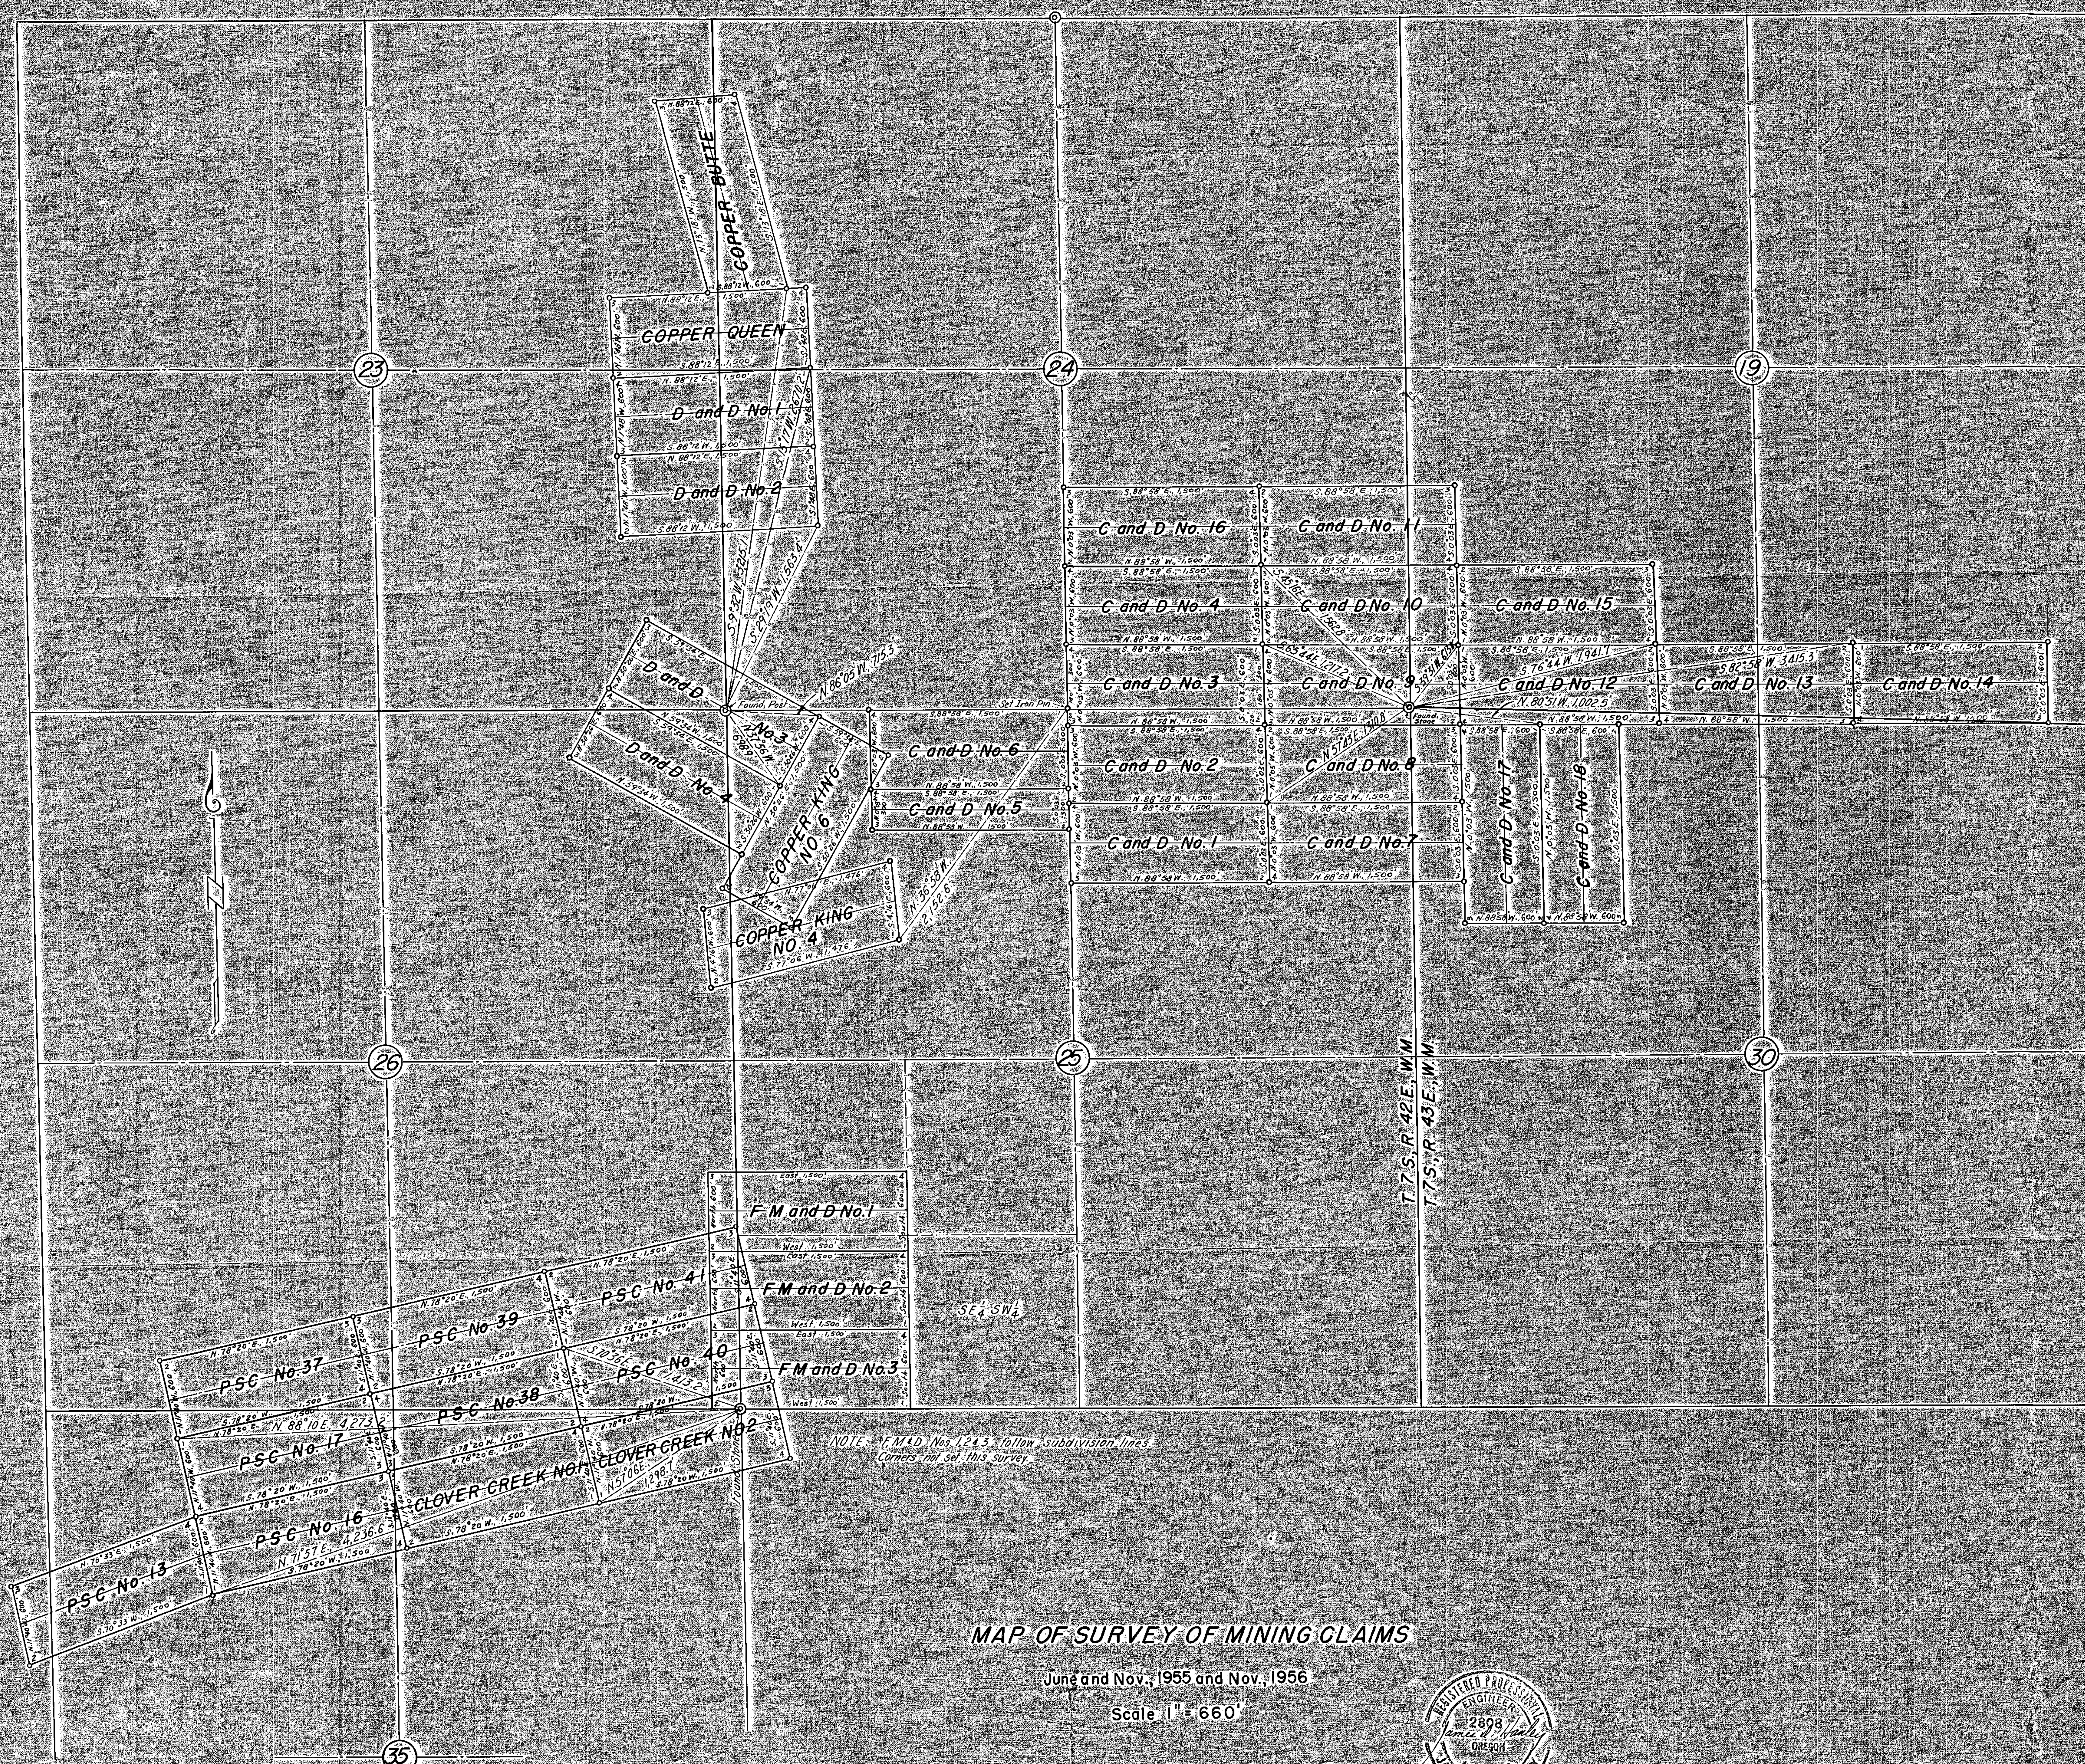

MAP OF SURVEY OF MINING CLAIMS
June and Nov., 1955 and Nov., 1956
Scale 1" = 660'
23
24
19
26
25
30
35
T. 7 S., R. 42 E., W.M.
T. 7 S., R. 43 E., W.M.
COPPER BUTTE
COPPER QUEEN
D and D No. 1
D and D No. 2
D and D
D and D No. 4
No. 3
COPPER KING NO. 6
COPPER KING NO. 4
C and D No. 16
C and D No. 11
C and D No. 4
C and D No. 10
C and D No. 15
C and D No. 3
C and D No. 9
C and D No. 12
C and D No. 13
C and D No. 14
C and D No. 6
C and D No. 2
C and D No. 8
C and D No. 5
C and D No. 1
C and D No. 7
C and D No. 17
C and D No. 18
Found Post
Set Iron Pin
Found Stone
N. 86°05' W. 715.3
S. 9°32' W. 3215.1
S. 29°19' W. 1563.4
S. 15°17' W. 2670.2
N. 36°58' W. 2,152.6
S. 76°44' W. 1941.7
S. 82°58' W. 3415.3
N. 80°51' W. 1002.5
N. 57°43' E. 1310.8
S. 65°44' E. 1217.2
S. 45°16' E. 1562.8
F M and D No. 1
F M and D No. 2
F M and D No. 3
SE¼ SW¼
PSC No. 41
PSC No. 39
PSC No. 40
PSC No. 37
PSC No. 38
PSC No. 17
PSC No. 16
PSC No. 13
CLOVER CREEK NO. 1
CLOVER CREEK NO. 2
N. 88°10' E. 4,273.2
N. 71°57' E. 4,236.6
N. 57°06' E. 1,298.7
S. 70°36' E. 1,413.2
NOTE: F.M.&D. Nos. 1, 2 & 3 follow subdivision lines. Corners not set this survey.
REGISTERED PROFESSIONAL ENGINEER
2808
OREGON
May 7, 1948
JAMES D. HANLEY
FILED Nov. 17, 1956
BAKER COUNTY SURVEYOR
SURVEY NO. 7-42-1
7-42-1