


CERTIFIED RECORD OF LAND CORNER MONUMENTATION

History of original corner establishment:

Stake 4 ft. long, 4-inches diam., set 18-inches in the ground for 1/4 Sec corner from which:

Pine 18 inches diam. bears N. 53° W., 18 lks. dist.
Pine 16 inches diam. bears S. 80° W., 24 lks. dist.

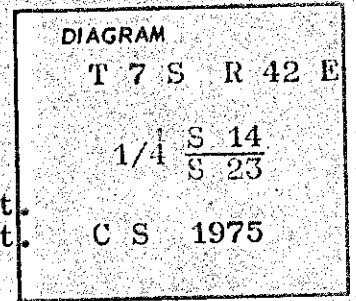

Description of corner evidences found:

Found stumps of both bearing trees with the scribed logs lying nearby. Did not find original corner stake.

Description of monument and accessories I established to perpetuate the original location of this corner

Set aluminum cap monument on 1-inch galvanized iron pipe marked as shown above, and scribed the following trees:

Pine 12 inches diam. bears N. 39° E., 29.4 ft., scribed 1/4 S 14 CS BT
Fir 9 inches diam. bears S. 80° W., 85.4 ft. scribed 1/4 S 23 CS BT



Office of County Surveyor County of Baker
 State of Oregon, I hereby certify that the within instrument was filed in this office
 for record on the 13 day of June, 1975
 _____ by Tom Hanley
 (COUNTY OFFICIAL) (DEPUTY)

BAKER COUNTY SURVEYOR
SURVEY NO. 7-42-4