


CERTIFIED RECORD OF LAND CORNER MONUMENTATION

History of original corner establishment:

Corner established by W. Barr, under contract # 355
June 14, 1880
Set 4" x 4" stake 18" in ground from which;
a pine 30" in diameter bears S76°E - 151 lks
a pine 30" in diameter bears N56½°E - 183 lks
a pine 15" in diameter bears S75°W - 237 lks

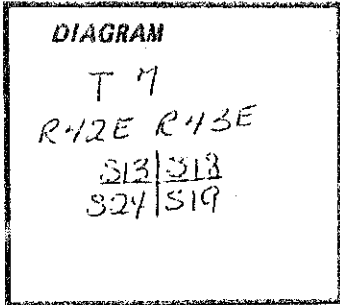

Description of corner evidence found:

Found:
31" ponderosa pine - S75°E - 151 lks - Scribed "S 19" (live)
27" ponderosa pine - N56°E - 183 lks - Scribed "S 13" "BT" (dead & down)
19" ponderosa pine - (school marm) - S77½°W - 237 lks - Scribed
"S24" "BT"
Dead 20 ft. snag

No evidence of original stake.


Description of monument and accessories I established to perpetuate the original location of this corner:

Set 2½" x 30" aluminum pipe with 3¼" aluminum cap 18" in ground to bedrock in mound of stone, marked:

Bearing Trees:

14" ponderosa pine - N14°W - 246.5 ft. - scribed "T7S R42E S13" in upper blaze and "BT" and brass tag stamped RLS 1664 in lower blaze.
14" douglas fir - N51½°E - 136.2 ft. - scribed "T7S R43E S18" in upper blaze and "BT" and brass tag stamped RLS 1664 in lower blaze.
10" ponderosa pine - S04°W - 120.0 ft. - scribed "T7S R42E S24" in upper blaze and "BT" and brass tag stamped RLS 1664 in lower blaze.

Compass declination 21½° East

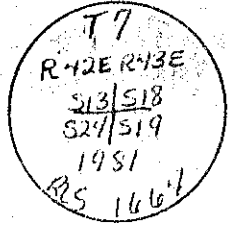

Note:

I set steel fence posts at corner with USFS Attention sign, placed USFS bearing tree signs on all bearing trees and painted red band on smooth bark at breast height on all bearing trees.

I hereby certify the above corner location was perpetuated as herein described in August 1981.

Frank Vaughn Frank Vaughn, Witness
Terry Eutler Terry Eutler, Witness

Office of..... County of.....
State of....., I hereby certify that the within instrument was filed in this office for record on the..... day of....., 19.....

..... by
(COUNTY OFFICIAL) (DEPUTY)

REGISTERED
PROFESSIONAL
LAND SURVEYOR

Carl E. Sundet

OREGON
JULY 14, 1978
CARL E. SUNDET
1664