

CERTIFIED RECORD OF LAND CORNER MONUMENTATION


History of original corner establishment:

W.B Barr conducted the survey of the exterior lines of Township 7 South, Range 42 East, W.M., Contract No. 355, dated June 14, 1880.

For the corner point Barr set a stake 4 ft. long 4 ins. dia. 11 ins. into the ground for 1/4 sec. corner from which:

- A Pine 15 ins. dia., bears S 11 1/2° W. at 53 lks. dist.
- A Pine 18 ins. dia., bears S. 89° E. at 79 lks. dist.

C-25

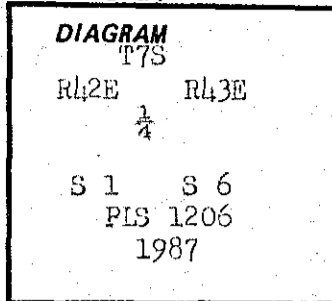

Description of corner evidence found:

Found a live 26" dia. P. Pine bearing S. 11 1/2° W. at 35.0 ft. dist. mkd. no scribe visible.

Description of monument and accessories I established to perpetuate the original location of this corner:

Set a 2 1/2" x 30" alum. pipe with a 2 1/2" alum. cap set 24" into the ground. Constructed a 36" dia. stone mound around the monument. Cap is marked as shown in the corner diagram. Reestablished original corner from bearing and distance from found bearing tree.

From the corner point: (New BT)

A 10" dia. Tamarack bears N. 53° E. at 28.8 ft. dist., mkd. 1/4 S 6 BT.

Set a steel fence post 4 ft. South from the monument and attached a USFS 54-9 sign. Painted the face of the blaze and a 6 in. band around the bearing trees red. Attached I.D. washer and USFS 54-9 and 54-3 signs to bearing trees. Used 18 1/2° declination on a staff compass for readings to bearing trees. Used a steel tape to measure to a nail set in the side of the trees.

This corner was monumented to USFS specifications on August 6, 1987, witnessed by Tom Fisk and Andy Marlette.

Office of.....Co. Surveyor..... County of..... Baker
State of..... OR....., I hereby certify that the within instrument was filed in this office for record on the..... day of....., 19....

(COUNTY OFFICIAL)

(DEPUTY)

Form R6-7100-57 (9/71)

FILED 9/28/87
BAKER COUNTY SURVEYOR
SURVEY NO. 7-42-7

