


CERTIFIED RECORD OF LAND CORNER MONUMENTATION

History of original corner establishment:

W. B. Barr conducted the survey of Township 7 South, Range 43 East, W.M., August 29 to September 8, 1881, under GLO Contract No. 388, dated May 7, 1881.

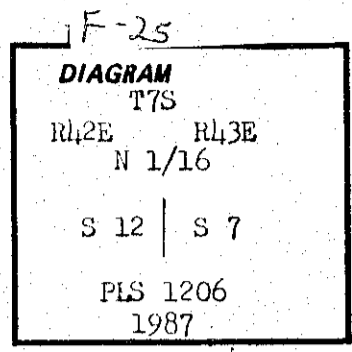

Description of corner evidence found:

None

Description of monument and accessories established to perpetuate the original location of this corner:

Set a 2 1/2" x 30" alum. pipe with a 2 1/2" alum. cap 24 ins. into the ground. Constructed a 36" dia. stone mound around the monument. The cap is marked as shown in the corner diagram.

From the corner point:

- A 11" dia. White Fir bears N. 51° W. at 5.8 ft. dist., marked N 1/16 S 12 BT.
- A 11" dia. White Fir bears S. 63° E. at 15.6 ft. dist., marked N 1/16 S 7 BT.

Set a steel fence post 4 ft. North of the monument and attached a USFS 54-2 sign. Set another steel fence post 4 ft. to the East and attached a USFS 54-2 and 54-9 signs. Painted the face of the blaze and a 6 in. band around the bearing trees red. Attached I.D. easer and USFS 54-9 and 54-3 signs to the bearing trees. Used 18 1/2° declination on a staff compass for readings to the bearing trees. Used a steel tape to measure to a nail set in the side of the trees.

This corner was monumented to USFS specifications on July 31, 1987, witnessed by Tom Fisk and Andy Marlette.

Office of... Co. Surveyor..... County of..... Baker
OR
State of....., I hereby certify that the within instrument was filed in this office
for record on the..... day of....., 19.....
..... by
(COUNTY OFFICIAL) (DEPUTY)