

CERTIFIED RECORD OF LAND CORNER MONUMENTATION

J-25


History of original corner establishment:

W. B. Barr conducted the survey of Township 7 South, Range 43 East, W.M., August 29 to September 8, 1881, under GLO Contract No. 388, dated May 7, 1881.

From the corner point:

Set a stake from which:

- A 8" Pine bears N. $56\frac{1}{2}^{\circ}$ W. at 15 lks. dist.
- A 18" Fir bears S. $56\frac{1}{2}^{\circ}$ W. at 20 lks. dist.
- A 8" Fir bears S. 70° E. at 25 lks. dist.
- A 12" Fir bears N. 81° E. at 36 lks. dist.

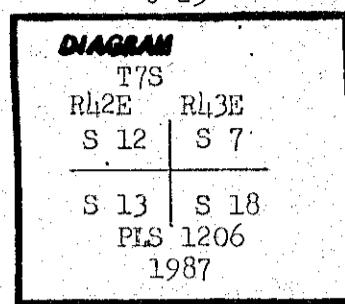

Description of corner evidence found:

Found a 20" dia. dead W. Fir bearing S. $56\frac{1}{2}^{\circ}$ W. at 13.2 ft. dist. mkd.

S 13

Description of monument and accessories I established to perpetuate the original location of this corner:

Set a $2\frac{1}{2}$ " x 30" alum. pipe with a $2\frac{1}{2}$ " alum. cap 28" into the ground. Constructed a 36" stone mound around the monument. The cap is marked as shown in the corner diagram.


From the corner point:

- A 13" dia. W. Fir bears N. 34° W. at 22.5 ft. dist. mkd., T7S R42E S12 BT.
- A 10" dia. W. Fir bears S. 66° W. at 14.3 ft. dist. mkd., T7S R42E S13 BT.
- A 17" dia. W. Fir bears N. 80° E., at 54.0 ft. dist. mkd. T7S R43E S 7 BT.
- A 10" L. Pine bears S 55° E. at 33.7 ft. dist. mkd. T7S R43E S18 BT.

Set a steel fence post $\frac{1}{4}$ " E. from the monument and attached a USFS 54-9 sign. Painted the face of the blaze and a 6 in. band around the bearing trees red. Attached I.D. washer and USFS 54-9 and 54-3 signs to bearing trees. Used $18\frac{1}{2}^{\circ}$ declination on a staff compass for readings to bearing trees. Used a steel tape to measure to a nail set in the side of the trees.

This corner was monumented to USFS specifications on July 31, 1987
witnessed by Tom Fisk and Larry McBroom.

County Surveyor Baker
Office of County of
State of OR I hereby certify that the within instrument was filed in this office
for record on the day of 19.....
..... by
I, COUNTY OFFICIALS

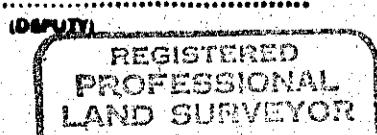

209-700-270

Form R6-7100-57 (9/71)

FILED 9/28/87

BAKER COUNTY SURVEYOR
SURVEY NO. 7-42-11

