

CERTIFIED RECORD OF LAND CORNER MONUMENTATION

L-25


History of original corner establishment:

W. B. Barr conducted the survey of Township 7 South, Range 43 East, W.M., August 29 to September 8, 1881, under GLO Contract No. 388, dated May 7, 1881.

The original notes of that survey relative to this corner state the following:

Set stake 4 ft. long 4 ins. dia., 18 ins. in the ground for $\frac{1}{4}$ sec. corner from which:

- A Pine, 6 ins. dia. bears N. 72° E. at 49 lks. dist.
- A Pine, 3 ins. dia. bears S. 83° W. at 44 lks. dist.

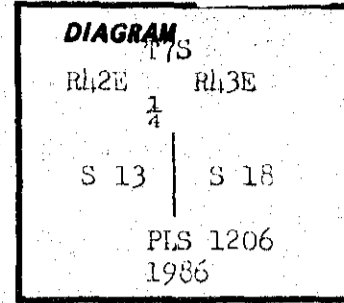

Description of corner evidence found:

No evidence was found after 12 man hours of searching. The area has been logged several times and there is evidence of an old forest fire.

Description of monument and accessories established to perpetuate the original location of this corner:

Set a 2 1/2" x 30" aluminum pipe with a 2 1/2" aluminum cap 24 ins. into the ground. Constructed a 36 in. dia. stone mound around the monument. The cap is marked as shown in the corner diagram. From the corner point:

- A P. Pine, 13 ins. dia., bears N. 69° E., at 38.0 ft. dist., mkd. $\frac{1}{4}$ S18 BT.
- A P. Pine, 11 ins. dia., bears S. 13° W., at 49.9 ft. dist., mkd. $\frac{1}{4}$ S13 BT.

Set a steel fence post 5 ft. to the North of the monument and attached a USFS 54-9 sign. Painted the face of the blaze and a 6 in. band around the bearing trees red. Attached I.D. washer and USFS 54-9 and 54-3 signs to bearing trees. Used 18 1/2° declination on a staff compass for readings to bearing trees. Used steel tape to measure to a nail set in the side of the trees.

This corner was remonumented to U.S.S specifications on August 27, 1986, witnessed by Tom Fisk, Larry McBroom and Wade Stone.

Office of.....County Surveyor..... County of..... Baker.....
State of..... Oregon....., I hereby certify that the within instrument was filed in this office
for record on the..... day of....., 19.....

..... by
(COUNTY OFFICIAL) (DEPUTY)

Form R6-7100-57 (9/71)

FILED 9/28/87
BAKER COUNTY SURVEYOR
SURVEY NO. 7-42-12

REGISTERED PROFESSIONAL LAND SURVEYOR * 490-798-276

James D. Hanley

OFFICIAL
SEPTEMBER 1987
JAMES D. HANLEY
1206