


CERTIFIED RECORD OF LAND CORNER MONUMENTATION

History of original corner establishment:

None

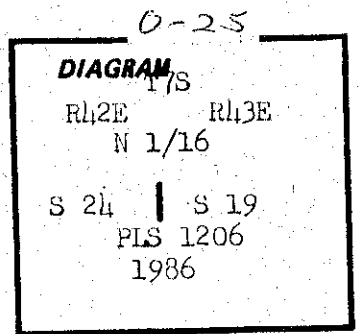

Description of corner evidence found:

None

Description of monument and accessories established to perpetuate the original location of this corner:

Set a 2½" x 30" alum. pipe with a 2½" alum. cap 10" into the ground. Constructed a 36 in. dia. stone mound around the monument. The cap is marked as shown in the corner diagram.

From the corner point:

P. Pine, 31 ins. dia., bears S. 56° E., at 156.9 ft. dist., mkd. N 1/16 S 19 BT.

A Stone, 5' x 3' x 2' bears N. 71° W., at 33.9 ft. dist., mkd X.

Set a steel fence post 4 ft. S. and set another post 4 ft. to the E. from the monument and attached a USFS 54-9 and 54-2 signs. Painted the face of the blaze and a 6 in. band around the bearing trees red. Attached I.D. washer and USFS 54-9 and 54-3 signs to bearing trees. Used 18½° declination on a staff compass for readings to bearing trees. Used a steel tape to measure to a nail set in the side of the tree.

This corner was monumented to USFS specifications on Dec. 22, 1986, witnessed by Tom Fisk and Larry McBroom.

County Surveyor

Baker

Office of..... County of.....

State of..... OR..... I hereby certify that the within instrument was filed in this office for record on the..... day of....., 19.....

(COUNTY OFFICIAL)

by

(DEPUTY)

Form R6-7100-57 (9/71)

FILED 9/28/87  
BAKER COUNTY SURVEYOR  
SURVEY NO. 7-42-13

