

CERTIFIED RECORD OF LAND CORNER MONUMENTATION


P-25

History of original corner establishment:

W. B. Barr conducted the survey of Township 7 South, Range 43 East, W.M., August 29 to September 8, 1881, under GLO Contract No. 388, dated May 7, 1881.

The original notes of that survey relative to this corner state the following:

Marked a Basalt stone 18" x 12" x 8" for $\frac{1}{4}$ sec. corner.
Raised mound of rock as per instructions.

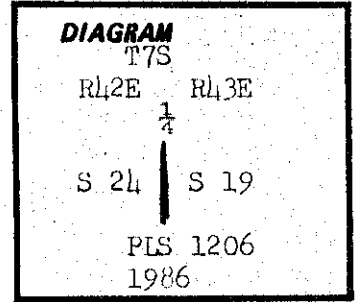

Description of corner evidence found:

Found a Basalt stone 18" x 12" x 8" with $\frac{1}{4}$ scratched into it. The stone was located in a fence jack in a new E-W fence. A old down E-W fence is 8' South of the new fence.

Description of monument and accessories I established to perpetuate the original location of this corner:

Set a 2 $\frac{1}{2}$ " x 30" aluminum pipe with a 2 $\frac{1}{2}$ " aluminum cap 30" into the ground. Constructed a 36 in. dia. stone mound around the monument. Buried the original corner stone 1 ft. North of the new monument. The cap is marked as shown in the corner diagram. From the corner point:

A Basalt boulder, 3' x 2' x 2' high, bears S. 20° E., at 101.0 ft. dist., mkd. X on the North face.

A Basalt rock outcrop, 15' x 8' x 4' high bears S. 20° W., at 146.2 ft. dist. mkd. X on top .

Set a steel fence post 4 ft. North of the monument and attached a 54-9 USFS sign. Painted the X's of the bearing objects. Used 18 $\frac{1}{2}$ ° declination on a staff compass for bearings to the BO's. Set the monument on a straight N-S line between the section corners and in the old E-W fence line.

This corner was remonumented to USFS specifications on Dec. 1, 1986, witnessed by Tom Fisk and Larry McBroom.

County Surveyor

Baker

Office of..... County of.....

State of Oregon..... I hereby certify that the within instrument was filed in this office

for record on the..... day of....., 19.....

..... by

(COUNTY OFFICIAL)

(DEPUTY)

Form R6-7100-57 (9/71)

FILED 9/28/87
BAKER COUNTY SURVEYOR
SURVEY NO. 7-42-14

REGISTERED
PROFESSIONAL
LAND SURVEYOR ★ GPO-788-176

James D. Hanley
OREGON
SEPTEMBER 23, 1971
JAMES D. HANLEY
1206