

CERTIFIED RECORD OF LAND CORNER MONUMENTATION


R-25

History of original corner establishment:

W. B. Barr conducted the survey of Township 7 South, Range 43 East, W.M., August 29 to September 8, 1881, under GLO Contract No. 388, dated May 7, 1881.

The original notes of that survey relative to this corner state the following:

Marked a Basalt stone 15" x 10" x 10" for corner to seg. 19, 24, 25, 30. Raised mound of stone as per instructions.

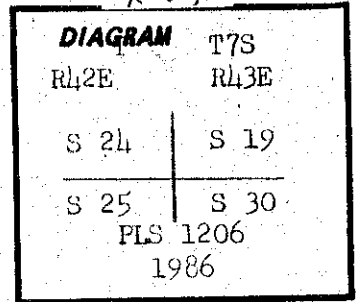

Description of corner evidence found:

Found a Basalt stone 12" x 12" x 10" in a old stone mound. The stone had a X chisled into it.

Description of monument and accessories I established to perpetuate the original location of this corner:

Set a 2 1/2" x 30" aluminum pipe with a 2 1/2" aluminum cap 26" into the ground. Constructed a 36" dia. stone mound around it. The cap is marked as shown in the corner diagram. From the corner point:

- A Basalt rock outcrop, 5' x 5', bears S. 26° E., at 127.6 ft. dist., mkd. X
- A Basalt rock outcrop, 3' x 3', bears N. 81° E., at 79.7 ft. dist., mkd. X

Set a steel fence post 5 ft. South from the monument and attached a 54-9 USFS sign. Used 18 1/2° declination on a staff compass to take bearings to the BO's.

This corner was remonumented to USFS specifications on Nov. 4, 1986, witnessed by Tom Fisk and Larry McBroom.

Office of.....County Surveyor..... County of..... Baker
 State of..... Oregon....., I hereby certify that the within instrument was filed in this office
 for record on the..... day of....., 19.....
 by
 (COUNTY OFFICIAL) (DEPUTY)

Form R6-7100-57 (9/71)

FILED 9/28/87
 BAKER COUNTY SURVEYOR
 SURVEY NO. 7-42-15

REGISTERED
 PROFESSIONAL
 LAND SURVEYOR
 OREGON
 * OPO-798-276

James D. Hanley
 JAMES D. HANLEY
 1205