


CERTIFIED RECORD OF LAND CORNER MONUMENTATION

History of original corner establishment:

W. B. Barr conducted the survey of Township 7 South, Range 43 East, W.M., August 29 to September 8, 1881, under GLO Contract No. 388, dated May 7, 1881.

The original notes of that survey relative to this corner state the following:

Marked a Basalt stone 18" x 8" x 6" for $\frac{1}{4}$ sec. corner. Raised mound of rock as per instructions.

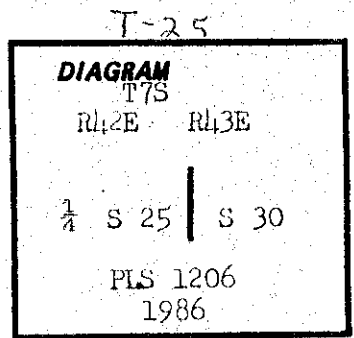

Description of corner evidence found:

Found a Basalt stone 20" x 10" x 7" layed over in a large stone mound marked with $\frac{1}{4}$ scratched on face.

Description of monument and accessories I established to perpetuate the original location of this corner:

Set a 2 $\frac{1}{2}$ " x 30" aluminum pipe with a 2 $\frac{1}{2}$ " aluminum cap 2 $\frac{1}{2}$ " into the ground. Constructed a 36" dia. stone mound around the monument. Cap is marked as shown in the corner diagram. Buried the original corner stone to the North of the new monument. From the corner point:

- A Basalt stone, 24" x 14" x 12" bears N. 75° E., at 70.4 ft. dist., mkd. X
- A Basalt stone, 30" x 18" x 12" bears S. 60° W., at 87.8 ft. dist., mkd. X

Set a steel fence post 5 ft. South from the monument and attached a USFS 54-9 sign. Used 18 $\frac{1}{2}$ ° declination for the bearings to the B.O.'s. Used a steel tape to measure to the X's of the bearing objects.

This corner was remonumented to USFS specifications on Dec. 1, 1986, witnessed by Tom Fisk and Larry McBroom.

County Surveyor Baker

Office of..... County of.....

State of..... Oregon..... I hereby certify that the within instrument was filed in this office for record on the..... day of....., 19.....

..... by

(COUNTY OFFICIAL)

(DEPUTY) REGISTERED PROFESSIONAL LAND SURVEYOR

James D. Hanley

JAMES D. HANLEY
1206

* OPO-798-278

Form R6-7100-57 (9/71)

FILED 9/28/87

BAKER COUNTY SURVEYOR

SURVEY NO. 7-42-16