

CERTIFIED RECORD OF LAND CORNER MONUMENTATION


V-25

History of original corner establishment:

W. B. Barr conducted the survey of Township 7 South, Range 43 East, W.M., August 29 to September 8, 1881, under GLO Contract No. 388, dated May 7, 1881.

The original notes of that survey relative to this corner state the following:

Marked a basalt rock 15" x 15" x 15" for corner to sections 25, 30, 31, 36. Raised mound of stone as per instructions.

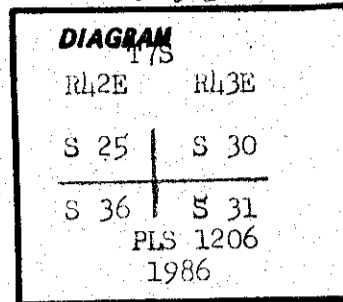

Description of corner evidence found:

Found a 17" x 14" x 12" basalt stone in a four way fence intersection. The stone had marked XXXI on one side.

Description of monument and accessories established to perpetuate the original location of this corner:

Set a steel fence post 4 ft. North of the monument and attached a USFS 54-9 sign. Set a 2 1/2" x 30" alum. pipe with a 2 1/2" alum. cap 22" into the ground. Constructed a 36" dia. stone mound around the monument. The cap is marked as shown in the corner diagram. Buried the original stone 1 ft. to the North of the monument. From the corner point:

- A boulder, 2' x 2' x 1' high, bears S. 53° W., at 196.2 ft. dist., mkd. X
- A rock outcrop, 18" x 16" x 6" high bears N. 44° W., at 66.9 ft. dist. mkd. X
- A 5/8" x 30" rebar, bears N. 46° E., at 20.0 ft. dist., set flush with the ground.
- A 5/8" x 30" rebar, bears S. 43° E., 20.0 ft. dist., set flush with the ground.

Used 18 1/2° declination on a staff compass for readings to the bearing objects.

This corner was re-monumented to USFS specifications on Dec. 1, 1986, witnessed by Tom Fisk and Larry McBroom.

Office of.....County Surveyor..... County of...Baker.....
State of.....Oregon..... I hereby certify that the within instrument was filed in this office
for record on the..... day of....., 19.....

..... by
(COUNTY OFFICIAL)

(DEPUTY) REGISTERED PROFESSIONAL LAND SURVEYOR GPO-788-276

Form R6-7100-57 (9/77)

FILED 9/28/87
BAKER COUNTY SURVEYOR
SURVEY NO. 7-42-17

James D. Hanley
JAMES D. HANLEY
1206