

RECORD OF LAND CORNER MONUMENTATION

EAST 1/16 CORNER SECTIONS 15 & 22, T. 7 S., R. 42 E., W.M.

ORIGINALLY ESTABLISHED BY: CORNER NOT PREVIOUSLY ESTABLISHED

CONTRACT NUMBER: N/A

CONTRACT DATE: N/A

16	15			15	14
21	22			22	23
21	22			22	23
28	27			27	26

ORIGINAL DESCRIPTION: N/A

EVIDENCE FOUND: N/A

DESCRIPTION OF MONUMENTS AND ACCESSORIES SET AND METHODS USED:

At the corner point as determined by survey, I set a standard USFS 2½"x30" aluminum pipe with attached ¾" aluminum cap, 28" in the ground. Surrounded the monument with a 2 ft. diameter collar of stone. Cap is marked as shown below.


From which, I SCRIBE A NEW BEARING TREE:

- ▶ A ponderosa pine 17" dbh bears N.46°W., 10.72 ft. marked E1/16 S15 in upper blaze and BT in lower blaze

Also from which, I SET A NEW REFERENCE POINT:

- ▶ A 5/8"x 30" iron pin, bears S.22°29'W., 14.47 ft., with attached 2" aluminum cap marked RP 1 2024 PLS 69454

CORNER MONUMENT MARKED:

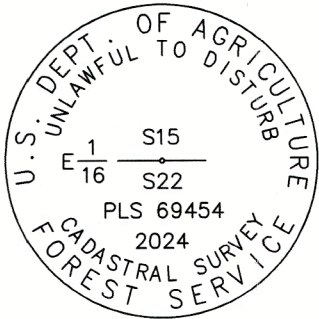

Placed a blue plastic-encased magnet at the base of the aluminum pipe. Painted a 6 inch red band around the new bearing tree, and also painted blazes red and attached USFS 54-3 and 54-9 signs. Used RTK GPS to measure reference point and bearing to BT. Used a steel tape to measure distance to the BT, measuring to a 6" Mag Spike driven in the side-center-right at the root crown of the tree, with an attached ½" aluminum washer stamped PLS 69454. Bearings are geodetic, derived by GPS observation at the corner. Set aluminum guard posts South and West, with USFS signs 54-2 and 54-9 attached.

RESTORATION BY, STAMP AND DATE:

Work performed April 9, 2024 by:

Jason L. Hatfield, PLS
Vince L. Kelly, Survey Technician
Spencer B. Jones, Survey Technician

USDA FOREST SERVICE
NORTHEAST OREGON LAND ZONE
1550 Dewey Avenue, Suite A
Baker City, OR 97814
(541) 523-1283

FILED May 23, 2024
BAKER COUNTY SURVEYOR
SURVEY NO. 7-42-33

