

RECORD OF LAND CORNER MONUMENTATION

CENTER-EAST 1/16 CORNER SECTION 22, T. 7 S., R. 42 E., W.M.

ORIGINALLY ESTABLISHED BY: CORNER NOT PREVIOUSLY ESTABLISHED

CONTRACT NUMBER: N/A

CONTRACT DATE: N/A

16	15			15	14
21	22			22	23
21	22			22	23
28	27			27	26

ORIGINAL DESCRIPTION: N/A

EVIDENCE FOUND: N/A


DESCRIPTION OF MONUMENTS AND ACCESSORIES SET AND METHODS USED:

At the corner point as determined by survey, I set a standard USFS 2½"x30" aluminum pipe with attached ¾" aluminum cap, 27" in the ground. Built a 2 ft. diameter mound of stone around the monument to top of cap. Cap is marked as shown below.

From which, I SCRIBE NEW BEARING TREES:

- ▶ A Douglas-fir 13" dbh bears N.59°30'E., 27.32 ft. marked CE1/16 S22 in upper blaze and BT in lower blaze
- ▶ A ponderosa pine 10" dbh bears N.71°30'W., 48.07 ft. marked CE1/16 S22 in upper blaze and BT in lower blaze

CORNER MONUMENT
MARKED:

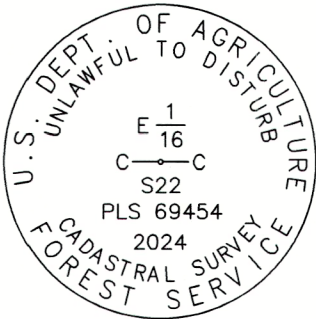

Placed a blue plastic-encased magnet at the base of the pipe. Painted a 6 inch red band around each bearing tree, and also painted blazes red and attached USFS 54-3 and 54-9 signs. Used RTK GPS to measure bearings to BT's. Distances to bearing trees measured with a steel tape to a 6" Mag Spike driven in the side-center-right at the root crown of each tree, with an attached 1½" aluminum washer stamped PLS 69454. Bearings are geodetic, derived by GPS observation at the corner. Set an aluminum guard post North, 5 ft. with USFS sign 54-2 attached, and another East, 6 ft. with USFS signs 54-2 and 54-9 attached.

RESTORATION BY, STAMP AND DATE:

Work completed April 15, 2024 by:

Jason L. Hatfield, PLS
Vince L. Kelly, Survey Technician
Spencer B. Jones, Survey Technician

USDA FOREST SERVICE
NORTHEAST OREGON LAND ZONE
1550 Dewey Avenue, Suite A
Baker City, OR 97814
(541) 523-1283

FILED May 23, 2024
BAKER COUNTY SURVEYOR
SURVEY NO. 7-42-37

