


RECORD OF LAND CORNER MONUMENTATION

CENTER 1/4 CORNER SECTION 24, T. 7 S., R. 42 E., W.M.

ORIGINALLY ESTABLISHED BY: CORNER NOT PREVIOUSLY ESTABLISHED

CONTRACT NUMBER: N/A

CONTRACT DATE: N/A

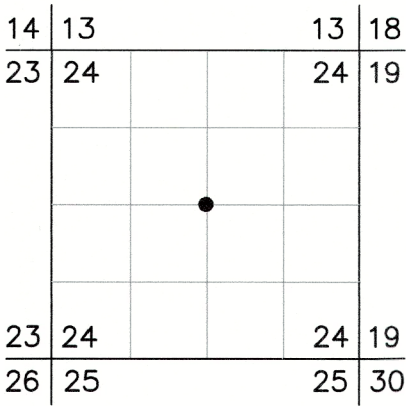

ORIGINAL DESCRIPTION: N/A

EVIDENCE FOUND: N/A


DESCRIPTION OF MONUMENTS AND ACCESSORIES SET AND METHODS USED:

At the corner point as determined by survey, I set a standard USFS 2½"x30" aluminum pipe with attached 3¼" aluminum cap, 22" in the ground. Built a 3 ft. diameter mound of stone around the monument to top of cap. Cap is marked as shown below.

From which, I SET NEW REFERENCE POINTS:

- ▶ A 5/8"x 24" iron pin, bears N.47°33'E., 10.36 ft., with attached 2" aluminum cap marked RP 1 2024 PLS 69454
- ▶ A 5/8"x 24" iron pin, bears S.45°21'E., 14.22 ft., with attached 2" aluminum cap marked RP 2 2024 PLS 69454
- ▶ A 5/8"x 24" iron pin, bears S.44°03'W., 38.05 ft., with attached 2" aluminum cap marked RP 3 2024 PLS 69454
- ▶ A 5/8"x 24" iron pin, bears N.45°32'W., 11.63 ft., with attached 2" aluminum cap marked RP 4 2024 PLS 69454

CORNER MONUMENT
MARKED:

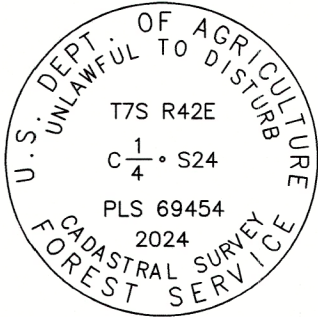

Placed a blue plastic-encased magnet at the base of the aluminum pipe. Used RTK GPS to measure accessories. Bearings are geodetic, derived by GPS observation at the corner.

RESTORATION BY, STAMP AND DATE:

Work performed April 17, 2024 by:

Jason L. Hatfield, PLS
Vince L. Kelly, Survey Technician
Spencer B. Jones, Survey Technician

USDA FOREST SERVICE
NORTHEAST OREGON LAND ZONE
1550 Dewey Avenue, Suite A
Baker City, OR 97814
(541) 523-1283

FILED May 23, 2024
BAKER COUNTY SURVEYOR
SURVEY NO. 7-42-40

