

RECORD OF LAND CORNER MONUMENTATION

CENTER-EAST 1/16 CORNER SECTION 24, T. 7 S., R. 42 E., W.M.

ORIGINALLY ESTABLISHED BY: CORNER NOT PREVIOUSLY ESTABLISHED

CONTRACT NUMBER: N/A

CONTRACT DATE: N/A

14	13			13	18
23	24			24	19
23	24			24	19
26	25			25	30

ORIGINAL DESCRIPTION: N/A

EVIDENCE FOUND: N/A


DESCRIPTION OF MONUMENTS AND ACCESSORIES SET AND METHODS USED:

At the corner point as determined by survey, I set a standard USFS 2½"x30" aluminum pipe with attached ¾" aluminum cap, 24" in the ground. Built a 3 ft. diameter mound of stone around the monument to top of cap. Cap is marked as shown below.

From which, I SET NEW REFERENCE POINTS:

- ▶ A 5/8"x 24" iron pin bears N.44°55'E., 26.54 ft., with attached 2" aluminum cap marked RP 1 2024 PLS 69454
- ▶ A 5/8"x 24" iron pin bears N.44°38'W., 13.52 ft., with attached 2" aluminum cap marked RP 2 2024 PLS 69454

CORNER MONUMENT
MARKED:

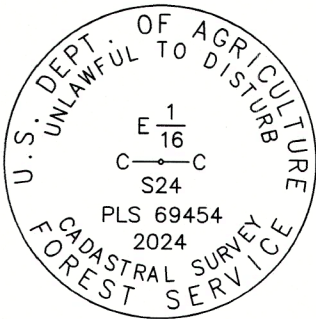

Placed a blue plastic-encased magnet at the base of the aluminum pipe. Used RTK GPS to measure accessories. Bearings are geodetic, derived by GPS observation at the corner. Set an aluminum guard post North, 5 ft. with USFS sign 54-2 attached, and another aluminum guard post East, 5 ft. with USFS signs 54-2 and 54-9 attached.

RESTORATION BY, STAMP AND DATE:

Work performed April 17, 2024 by:

Jason L. Hatfield, PLS
Vince L. Kelly, Survey Technician
Spencer B. Jones, Survey Technician

USDA FOREST SERVICE
NORTHEAST OREGON LAND ZONE
1550 Dewey Avenue, Suite A
Baker City, OR 97814
(541) 523-1283

FILED May 23, 2024
BAKER COUNTY SURVEYOR
SURVEY NO. 7-42-41

