

CERTIFIED RECORD OF LAND CORNER MONUMENTATION


History of original corner establishment:

Corner established by W. B. Barr under G L O contract No. 388 dated May 7, 1881.

Surveyor's General records state:

Marked basalt rock 12x12x6 for 1/4 sec from which:

Pine, 10 ins diam bears N 88° E, 131 lks dist  
 Pine, 6 ins diam bears S 22° W, 169 lks dist

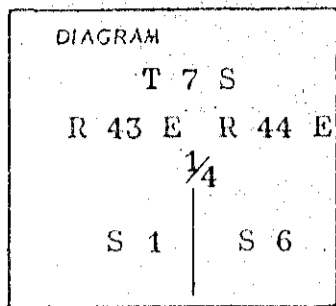

Description of corner evidence found:

None

Corner remonumented by single proportionate measure between the north-east corner of Section 6 (township corner) and the west quarter-section corner of Section 7.


Description of monument and accessories established to perpetuate the original location of this corner

Set a 2 1/2 inch brass cap on a 1 inch iron pipe, 31 inches long, 24 inches in the ground with a surrounding dirt and rock mound, from which:

New bearing trees:

A fir, 12 inches diam bears S 14° E, 24.9 ft dist marked 1/4 S 6 BT  
 A fir, 6 inches diam bears S 11° W, 25.7 ft dist marked 1/4 S 1 BT

Brass cap marked thus: T 7 S  
 R 43 E R 44 E

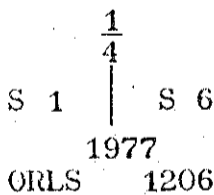

REGISTERED  
 PROFESSIONAL  
 LAND SURVEYOR

*William L. Hanley*

OREGON  
 JULY 14, 1978  
 WILLIAM L. HANLEY  
 1639

I hereby certify that the above corner monument was properly re-established on July 25, 1978 witnessed by B. Hanley and R. Spivey.

Office of County Surveyor..... County of Baker

State of Oregon....., I hereby certify that the within instrument was filed in this office for record on the ..... day of .....

..... by .....  
 (COUNTY OFFICIAL) (DEPUTY)

FILED August 11, 1978

BAKER COUNTY SURVEYOR

SURVEY NO. 7-44-7

7-43-1