

CERTIFIED RECORD OF LAND CORNER MONUMENTATION


History of original corner establishment:

Corner established by W. B. Barr under GLO contract no. 388 dated May 5, 1881.

Surveyor General's records state:

Marked basalt rock 12 x 10 x 8 for corner to Sec. 2, 3, 10, 11 from which:

Pine 12 in diam bears N 85½° W, 23 lks dist
 " 15 in diam bears S 12½° W, 19 lks dist
 " 28 in diam bears S 67° E, 41 lks dist
 Fir 30 in diam bears N 69° E, 43 lks dist

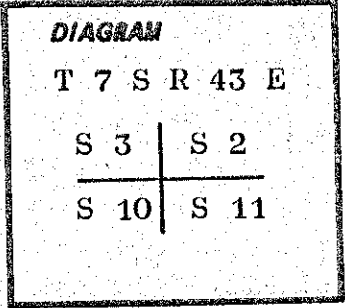

Description of corner evidence found:


At the approximate corner location found a 30 inch diameter sawed fir stump with BT scribes visible for Section 2 bearing tree. Also, found the rotten remains of Sections 3 and 10 bearing trees. No trace of the Section 11 bearing tree as it is in an existing roadway.

At corner location as determined by the above accessory evidence found a mound of stone. Original marked stone was not identified.

Description of monument and accessories established to perpetuate the original location of this corner:

Set a 2½ inch brass cap on a 1 inch iron pipe 31 inches long and projecting 4 inches above ground with a surrounding rock mound.

Brass cap marked thus: T 7 S R 43 E

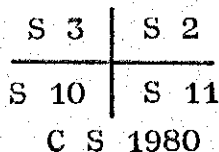

New bearing trees established:

A fir 7 ins diam bears N 74° E, 40.6 ft dist mkd T 7 S R 43 E S 2 BT
 A fir 17 ins diam bears S 32° E, 11.2 ft dist mkd T 7 S R 43 E S 11 BT
 A pine 20 ins diam bears S 48° W, 23.9 ft dist mkd T 7 S R 43 E S 10 BT
 A pine 12 ins diam bears N 09° W, 31.9 ft dist mkd T 7 S R 43 E, S 3 BT

I hereby certify that the above described corner monument was properly remonumented under my supervision on June 26, 1980, and witnessed by Bill Hanley, Brad Gordon, Tom Fisk, and Jim DeMastus.

REGISTERED
PROFESSIONAL
LAND SURVEYOR

James D. Hanley
 OREGON
 SEPTEMBER 23, 1977
 JAMES D. HANLEY
 1206

Office of...County Surveyor..... County of...Baker.....
 State of...Oregon....., I hereby certify that the within instrument was filed in this office
 for record on the...15 day of...July....., 1980
 by
 (COUNTY OFFICIAL) (DEPUTY)

Form R6-7100-5/ (9/71)

FILED July 15, 1980
 BAKER COUNTY SURVEYOR
 SURVEY NO. 7-43-3