

CERTIFIED RECORD OF LAND CORNER MONUMENTATION


History of original corner establishment:

Corner established by W. B. Barr under GLO contract no. 388 dated May 5, 1881.

Surveyor' General's records state:

Marked basalt rock 12 x 10 x 6 for 1/4 Sec corner from which:

Pine 6 in diam bears S 41 1/2° W, 57 lks dist
" 30 " " " N 13° E, 62 " "

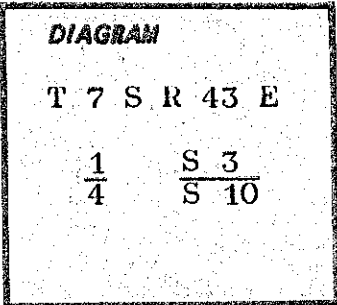

Description of corner evidence found:

At the approximate corner location found a ponderosa pine, 17 ins diam., for Section 10 bearing tree and a sawed stump for Section 3 bearing tree.

At corner location as determined by the bearing tree and stump found a basalt stone 16 x 11 x 8 ins marked 1/4.

Description of monument and accessories established to perpetuate the original location of this corner:

Set a 2 1/2 inch brass cap on a 2 inch iron pipe 31 inches long and projecting 5 inches out of the ground with a surrounding rock mound. Buried original stone face down on north side of brass cap monument.

Brass cap marked thus: T 7 S R 43 E

1/4 S 3
S 10

CS 1980

New bearing tree established:

A pine 16 ins diam bears N 85° E, 19.9 ft dist marked 1/4 S 3 BT

I hereby certify that the above described corner monument was properly remonumented under my supervision on July 2, 1980, and witnessed by Brad Gordon and Tom Fisk.

REGISTERED
PROFESSIONAL
LAND SURVEYOR

James D. Hanley
OREGON
SEPTEMBER 23, 1977
JAMES D. HANLEY
1206

Office of... County Surveyor Baker
State of... Oregon... I hereby certify that the within instrument was filed in this office
for record on the... 15 day of... July... 19... 80
..... by

(COUNTY OFFICIAL)

(DEPUTY)

Form R6-7100-57 (9/71)

FILED July 15, 1980
BAKER COUNTY SURVEYOR
SURVEY NO. 7-43-4