


CERTIFIED RECORD OF LAND CORNER MONUMENTATION

History of original corner establishment:

Original corner established by W. Barr under contract #388, dated May 7, 1881

- Set stake 4" x 4", 18" in ground from which;
- a pine 14" in diameter bears N68½°W - 50 lks
- a pine 24" in diameter bears N16°E - 181 lks
- a pine 15" in diameter bears S56°W - 171 lks
- a pine 14" in diameter bears S6°E - 175 lks

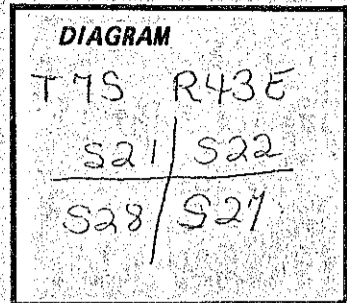

Description of corner evidence found:

Found unrecorded mound of stone.

Found:

30" ponderosa pine - live and open upper blaze N22°E
181 lks to face scribed "S 22"


10" ponderosa pine - dead and down - N65°W - 50 lks
Scribed "S" & "B"

17" ponderosa pine - dead and down - S58°W - 87.8 ft.
with chopped open face.

Dead and down almost completely decayed pine S05°E
175 lks - no visible scribing.

Description of monument and accessories established to perpetuate the original location of this corner:

Set 2½" x 30" aluminum pipe with ¾" aluminum cap 12" in ground to bedrock, in large mound of stone, marked: Chisled "X" on bedrock below cap for corner point.

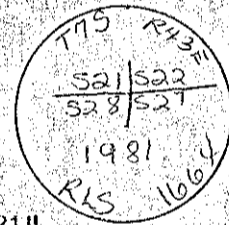

Bearing trees:

7" ponderosa pine - N88°W - 137.0 ft. - scribed "T7S R43E S21" in upper blaze and "BT" and brass tag stamped RLS 1664 in lower blaze

7" ponderosa pine - S76°W - 153.2 ft. - scribed "T7S R43E S28" in upper blaze and "BT" and brass tag stamped RLS 1664 in lower blaze

14" ponderosa pine - S47°E - 195.2 ft. - scribed "T7S R43E S27" in upper blaze and "BT" and brass tag stamped RLS 1664 in lower blaze

Compass declination 20½° East

Note:

I set steel fence post at corner with USFS Attention sign, placed USFS bearing tree signs on all bearing trees and painted red band on smooth bark at breast height on all bearing trees.

I hereby certify the above corner location was perpetuated as herein described in August 1981

REGISTERED
PROFESSIONAL
LAND SURVEYOR

Carl E. Sundet

OREGON
JULY 14, 1978
CARL E. SUNDET
1664

Perry Butler Perry Butler, Witness

Frank Vaughn Frank Vaughn, Witness

Office of..... County of.....

State of..... I hereby certify that the within instrument was filed in this office

for record on the..... day of....., 19.....

..... by.....

(COUNTY OFFICIAL)

(DEPUTY)