


CERTIFIED RECORD OF LAND CORNER MONUMENTATION

History of original corner establishment:

Corner originally established by W. Barr under contract #388, dated May 7, 1881.

Set basalt rock 20"x16"x11".
No accessories set.

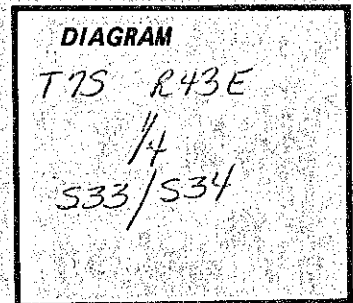


Description of corner evidence found:

Found 20" x 16" x 4" stone with 1/4 on west face in a mound.

No bearing trees originally set.

Description of monument and accessories established to perpetuate the original location of this corner:

Set 2 1/2" x 30" aluminum pipe with 3 1/4" aluminum cap 16" in ground to bedrock, in large mound of stone, marked; Buried original stone alongside pipe.

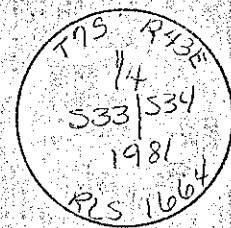

Accessories;

- A 5 ft. x 2 1/2 ft. mound of stone - N27°W - 20.6 ft.
- A 4 ft. x 2 1/2 ft. mound of stone - S68°E - 21.0 ft.

Compass declination 21 1/2° East

Note:

I set steel fence post at corner with USFS attention sign, placed USFS bearing tree signs on all ~~COUNTRIES~~ ~~CL~~ ~~STATE~~ ~~SMOOTHED~~ ~~TREES~~ at breast height on all bearing trees.

I hereby certify the above corner location was perpetuated as herein described in August 1981.

Terry Butler Terry Butler, Witness

Frank Vaughn Frank Vaughn, Witness

REGISTERED
PROFESSIONAL
LAND SURVEYOR

Carl E. Sundet

OREGON
JULY 14, 1978
CARL E. SUNDET
1554

Office of..... County of.....
State of....., I hereby certify that the within instrument was filed in this office
for record on the..... day of....., 19.....
..... by

(COUNTY OFFICIAL)

(DEPUTY)

Form R6-7100-57 (9/71)

FILED Oct 22, 1981
BAKER COUNTY SURVEYOR
SURVEY NO. 7-43-8

☆ GPO—798-276