


CERTIFIED RECORD OF LAND CORNER MONUMENTATION

History of original corner establishment:

Corner originally established by W. Barr under contract # 388, dated May 7, 1881
Set basalt stone 12" x 10" x 6" from which;
a pine 18" in diameter bears N55½°E - 65 lks
a fir 14" in diameter bears S75°W - 29 lks

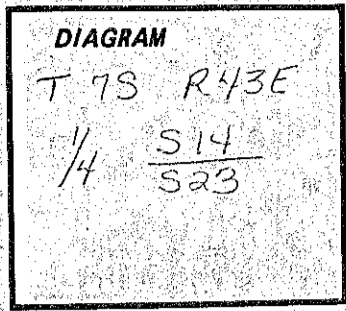

Description of corner evidence found:

Found:

18" ponderosa pine - N55½°E - 65lks - dead & down - face is weathered. No visible scribing
20" douglas fir - S26½°W - 29 lks - with healed face - cut into upper face. Scribed "S"
No evidence of original stone.

Description of monument and accessories established to perpetuate the original location of this corner:

Set 2½" x 30" aluminum pipe with ¾" aluminum cap 24" in ground in a mound of stone, marked:
Set 5½" steel fence post with 54-4 sign 4' east.



Bearing trees:

11" douglas fir - N65°W - 27.9 ft. - scribed "¼ S14" in upper blaze and "BT" and brass tag stamped RLS 1664 in lower blaze
9" douglas fir - S24°E - 36.5 ft. - scribed "¼ S23" in upper blaze and "BT" and brass tag stamped RLS 1664 in lower blaze

Compass declination 21° East

Note:

I set steel fence post at corner with USFS Attention sign, placed USFS bearing tree signs on all bearing trees and painted red band on smooth bark at breast height on all bearing trees.

I hereby certify the above corner location was perpetuated as herein described in August 1981.

Terry Butler Terry Butler, Witness
Frank Vaughn Frank Vaughn, Witness

REGISTERED
PROFESSIONAL
LAND SURVEYOR

Carl E. Sundet

OREGON
JULY 14, 1978
CARL E. SUNDET
1664

Office of..... County of.....
State of..... I hereby certify that the within instrument was filed in this office
for record on the..... day of....., 19.....
..... by

(COUNTY OFFICIAL)

(DEPUTY)