


CERTIFIED RECORD OF LAND CORNER MONUMENTATION

History of original corner establishment:

Corner originally established by W. Barr under contract # 388, dated May 7, 1881
 Set 4"x4" stake 18" in ground from which,
 a tamarack 14" in diameter bears N17½°E - 47 lks
 a tamarack 14" in diameter bears N57½°W - 30 lks
 a pine 36" in diameter bears S58°W - 41 lks
 a pine 18" in diameter bears S30°E - 86 lks

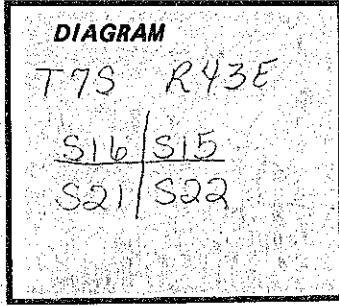

Description of corner evidence found:

Found:

Rotten tamarack - N37½°W - 30 lks. - no scribing
 Rotten ponderosa pine stump - S30°E - 86 lks. - no scribing
 Broken 20" tamarack - N21°E - 50 lks - scribed "15"
 32" ponderosa pine - dead & down - S58°W - 41 lks - scribed

"21" "BT"
 No evidence of post

Description of monument and accessories I established to perpetuate the original location of this corner:

Set 2½" x 30" aluminum pipe with ¾" aluminum cap 24" in ground, marked:
 No stones nearby for mound.



Bearing trees:

8" douglas fir - N37°W - 39.7 ft. - scribed "T7S R43E S16" in upper blaze and "BT" and brass tag stamped RLS 1664 in lower blaze
 11" ponderosa pine - S88°W - 9.6 ft. - scribed "T7S R43E S21" in upper blaze and "BT" and brass tag stamped RLS 1664 in lower blaze
 10" ponderosa pine - S74°E - 16.8 ft. - scribed "T7S R43E S22" in upper blaze and "BT" and brass tag stamped RLS 1664 in lower blaze
 7" ponderosa pine - N58°E - 11.6 ft. - scribed "T7S R43E S15" in upper blaze and "BT" and brass tag stamped RLS 1664 in lower blaze.
 Compass declination 20¼° East

Note:

I set steel fence posts at corner with USFS Attention sign, placed USFS bearing tree signs on all bearing trees and painted red band on smooth bark at breast height on all bearing trees.

I hereby certify the above corner location was perpetuated as herein described in August 1981.

REGISTERED
 PROFESSIONAL
 LAND SURVEYOR

Carl E. Sundet

OREGON
 JULY 14, 1978
 CARL E. SUNDET
 1664

Terry Butler Terry Butler, Witness
Frank Vaughn Frank Vaughn, Witness

Office of..... County of.....
 State of..... I hereby certify that the within instrument was filed in this office
 for record on the..... day of....., 19.....
 by.....
 (COUNTY OFFICIAL) (DEPUTY)