

CERTIFIED RECORD OF LAND CORNER MONUMENTATION

T. 7 S. R. 43 E.


History of original corner establishment:

Corner established by Gordon C. Smith, under instructions dated January 13, 1940, for mineral survey #867.

Set a 1"x36" galvanized iron pipe 28" in ground, marked F2-L1-867, from which;

a fir 6" in diameter bears S 15° E 28.8 feet distance, marked F2-L1-867 BT

a fir 6" in diameter bears N 21° E 28.0 feet distance, marked "F2-L1-867 BT"

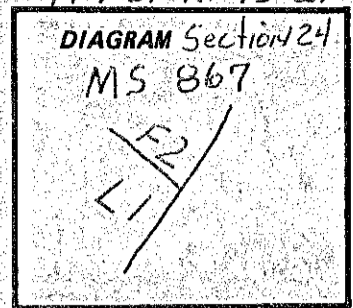

Description of corner evidence found:

Found 1" pipe with no markings 1 foot northeast of corner position. Unrecorded pipe.

Found white fir 18" in diameter S 15° E 28.8 feet distance, with healed face. Tree is alive.

Found stump hole with badly decayed log alongside N 21° E 28.0 feet distance, no scribing.

All distances are side and center to bearing trees.


Description of monument and accessories established to perpetuate the original location of this corner:

Set 2 1/2"x30" aluminum pipe with 3 1/4" aluminum cap 26" in ground in mound of stone. Cap marked;

Bearing trees

a ponderosa pine 7" in diameter bears S 66 1/2° E 28.4 feet distance, scribed "F2 L-1 MS867" in upper blaze and "BT" and brass tag stamped RLS 1664 in lower blaze.

Compass declination 20° East

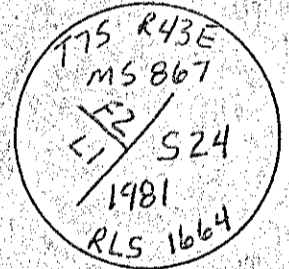

Note

I set a steel fence post with USFS Attention sign at corner, placed USFS 54-8 signs on all bearing trees, and painted red band on smooth bark at breast height on all bearing trees.

I certify the above corner location was perpetuated as herein described on September 17, 1981.

Terry Eutler, Witness  
Frank Vaughn, Witness

REGISTERED  
PROFESSIONAL  
LAND SURVEYOR

Carl E. Sundet  
OREGON  
JULY 14, 1978  
CARL E. SUNDET  
1664

Office of..... County of.....  
State of....., I hereby certify that the within instrument was filed in this office  
for record on the..... day of....., 19.....  
..... by.....  
(COUNTY OFFICIAL) (DEPUTY)