

CERTIFIED RECORD OF LAND CORNER MONUMENTATION


History of original corner establishment:

Corner established by Gordon C. Smith, under instructions dated January 13, 1940, for mineral survey #867.

Set a 1"x36" galvanized iron pipe 28" in ground, marked "C21-NY2-F3-L4-867" from which;

a fir 14" in diameter bears N 30° E 68.7 feet distance, marked "C21-NY2-F3-L4-867 BT"

a pine 18" in diameter bears N 14° E 34.3 feet distance, marked "C21-NY2-F3-L4-867 BT"

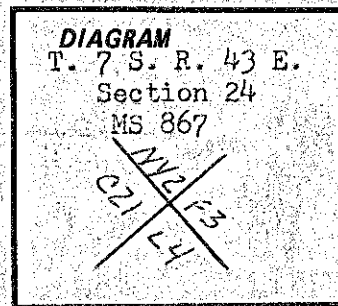

Description of corner evidence found:

Found pipe out of position. Set pipe alongside of new monument.

Found ponderosa pine 24" in diameter, N 14° E 34.3 feet distance. Tree is alive with open, weathered face; scribed "F3-C21 867 BT"

Found fir stump with a log alongside N 36½° E 66.0 feet distance, scribed "867 BT", other scribing weathered and/or grown over.

All distances are to side and center of bearing trees.

Description of monument and accessories I established to perpetuate the original location of this corner:

Set 2½"x30" aluminum pipe with 3¼" aluminum cap 26" in ground in mound of stone. Cap marked;

Bearing trees

a ponderosa pine 7" in diameter bears N 46½° W 12.2 feet distance, scribed "C21-NY2-F3-L4MS867" in upper blaze and "BT" and brass tag stamped RLS 1664 in lower blaze.

a ponderosa pine 6" in diameter bears N 82½° E 7.0 feet distance, scribed "C21-NY2-F3-L4MS867" in upper blaze and "BT" and brass tag stamped RLS 1664 in lower blaze.

Compass declination 20° East

Note



I set a steel fence post with USFS Attention sign at corner, placed USFS 54-8 signs on all bearing trees, and painted red band on smooth bark at breast height on all bearing trees.

I hereby certify the above corner location was perpetuated as herein described on September 19, 1981.


Terry Butler, Witness

Frank Vaughn

Frank Vaughn, Witness

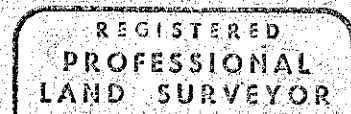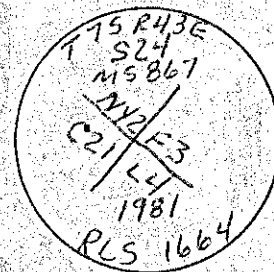

Carl E. Sundet

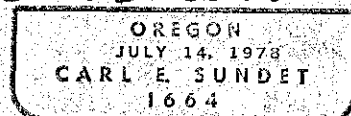

Office of..... County of.....

State of....., I hereby certify that the within instrument was filed in this office

for record on the..... day of....., 19.....

..... by
(COUNTY OFFICIAL) (DEPUTY)