


CERTIFIED RECORD OF LAND CORNER MONUMENTATION

History of original corner establishment:

Corner established by Gordon C. Smith, under instructions dated January 13, 1940, for mineral survey #867.

Set a 1"x36" galvanized iron pipe 28" in ground, marked "NY1-F4-867" from which;
a tamarack 6" in diameter bears N 23° W 19.0 feet distance, marked "NY1-F4-867 BT".

a tamarack 6" in diameter bears S 80° E 6.0 feet distance, marked "NY1-F4-867 BT"

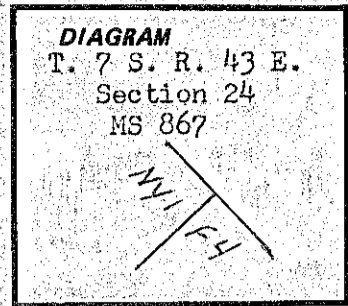

Description of corner evidence found:

Found no evidence of original pipe.

Found dead and down tamarack 6" in diameter N 23° W 6.0 feet distance, scribing unreadable.

Found tamarack 11" in diameter S 80° E 19.0 feet distance, alive with healed face.

Distances to side and center of bearing trees.

It appears the distances were reversed to the two bearing trees.

Description of monument and accessories I established to perpetuate the original location of this corner:

Set 2 1/2"x30" aluminum pipe with 3/4" aluminum cap 26" in ground in mound of stone. Cap marked;

Bearing trees

a ponderosa pine 7" in diameter bears N 67 1/2° W 24.3 feet distance, scribed "NY1-F4MS867" in upper blaze and "BT" and brass tag stamped RLS 1664 in lower blaze.

Compass declination 20° East

Note


I set a steel fence post with USFS Attention sign at corner, placed USFS 54-8 signs on all bearing trees, and painted red band on smooth bark band at breast height on all bearing trees.

I hereby certify the above corner location was perpetuated as herein described on September 19, 1981.

Terry Butler, Witness

Frank Vaughn

Frank Vaughn, Witness

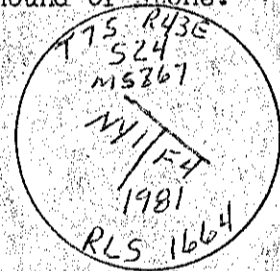

REGISTERED PROFESSIONAL LAND SURVEYOR

Carl E. Sundet

OREGON JULY 14, 1978 CARL E. SUNDET 1664

Office of..... County of.....

State of....., I hereby certify that the within instrument was filed in this office for record on the..... day of....., 19.....

..... by

(COUNTY OFFICIAL)

(DEPUTY)

Form R6-7100-57 (9/71)

FILED OCT 22, 1981 BAKER COUNTY SURVEYOR SURVEY NO. 7-43-15

☆ GPO-798-276