


CERTIFIED RECORD OF LAND CORNER MONUMENTATION

History of original corner establishment:

Corner originally established by W. Barr under contract # 388, dated May 7, 1881

Set 16"x16"x5" slate stone, from which,
a fir - 18" in diameter bears N62°W - 46 lks
a pine - 18" in diameter bears S63°E - 44 lks

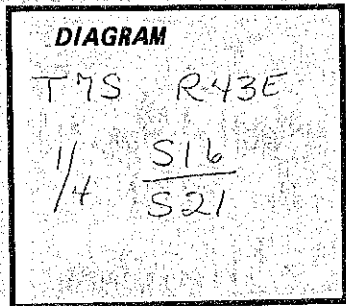

Description of corner evidence found:

Found 16" x16" x 5" stone with 1/4 on north face

Found:

20" douglas fir - dead and down - N63°W - 46 lks to face
scribed 1/4 S - 32.0 ft. side and center

32" ponderosa pine - live and healed face - bears S57 1/2° E
44 lks to face - 30.0 ft. side and center

Description of monument and accessories I established to perpetuate the original location of this corner:


Set 2 1/2" x 30" aluminum pipe with 3 1/4" aluminum cap 16" in ground, to bedrock, in mound of stone, marked:

Buried original stone alongside pipe.

Bearing trees:

12" ponderosa pine - N42°W - 42.4 ft. - scribed "1/4 S16" in upper blaze and "BT" and brass tag stamped RLS 1664 in lower blaze

Compass declination 22° East

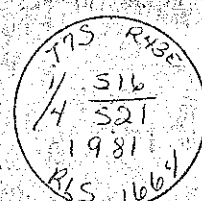

Note:

I set steel fence posts at corner with USFS Attention sign, placed USFS bearing tree signs on all bearing trees, and painted red band on smooth bark at breast height on all bearing trees.

I hereby certify the above corner location was perpetuated as herein described in August 1981.

Terry Butler Terry Butler, Witness

Frank Vaughn Frank Vaughn, Witness

REGISTERED
PROFESSIONAL
LAND SURVEYOR

Carl E. Sundet

OREGON
JULY 14, 1978
CARL E. SUNDET
1564

Office of..... County of.....
State of....., I hereby certify that the within instrument was filed in this office
for record on the..... day of....., 19.....
..... by
(COUNTY OFFICIAL) (DEPUTY)