


CERTIFIED RECORD OF LAND CORNER MONUMENTATION

History of original corner establishment:

Corner originally established by W. Barr under contract # 388, dated May 7, 1881
 Set basalt stone 16" x 10" x 6" from which;
 a tamarack 24" in diameter bears N54 $\frac{1}{2}$ °W - 55 lks
 a tamarack 4" in diameter bears N57 $\frac{1}{2}$ °E - 54 lks
 a tamarack 26" in diameter bears S 7 $\frac{1}{4}$ °E - 38 lks
 a tamarack 6" in diameter bears S47°W - 34 lks

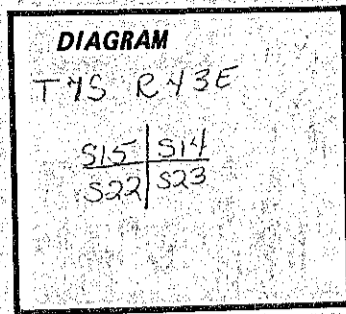

Description of corner evidence found:

Found:

- 9" tamarack - N39°E - 54 lks - dead & down - scribed "S"
- 26" tamarack - N52°W - 55 lks - stump - scribed "BT"
- 20" tamarack - S49°W - 34 lks - face chopped open - no visible scribing
- 26" tamarack - S70 $\frac{1}{2}$ °E - 38 lks - stump - no visible scribing

No evidence of original stone.

Description of monument and accessories established to perpetuate the original location of this corner:

Set 2 $\frac{1}{2}$ " x 30" aluminum pipe with 3 $\frac{1}{4}$ " aluminum cap 26" in ground, marked:
 No stones available for mound.



Bearing trees:

- 10" douglas fir - N12°W - 54.0 ft. - scribed "T7S R43E S15" in upper blaze and "BT" and brass tag stamped RLS 1664 in lower blaze
 - 15" ponderosa pine - N28°E - 43.8 ft. - scribed "T7S R43E S14" in upper blaze and "BT" and brass tag stamped RLS 1664 in lower blaze
 - 15" douglas fir - S85°W - 46.6 ft. - scribed "T7S R43E S22" in upper blaze and "BT" and brass tag stamped RLS 1664 in lower blaze
 - 16" douglas fir - S63 $\frac{1}{2}$ °E - 51.0 ft. - scribed "T7S R43E S23" in upper blaze and "BT" and brass tag stamped RLS 1664 in lower blaze
- Compass declination 21 $\frac{1}{4}$ ° East

REGISTERED
 PROFESSIONAL
 SURVEYOR

Carl E. Sundet

OREGON
 JULY 14, 1978
 CARL E. SUNDET
 1664

Note:

I set steel fence posts at corner with USFS Attention sign, placed USFS bearing tree signs on all bearing trees and painted red band on smooth bark at breast height on all bearing trees.

I hereby certify the above corner location was perpetuated as herein described in August 1981.

Terry Butler Terry Butler, Witness
Frank Vaughn Frank Vaughn, Witness

Office of..... County of.....
 State of..... I hereby certify that the within instrument was filed in this office
 for record on the..... day of....., 19.....
 by
 (COUNTY OFFICIAL) (DEPUTY)