


CERTIFIED RECORD OF LAND CORNER MONUMENTATION

History of original corner establishment:

Corner originally established by W. Barr under contract # 388, dated May 7, 1881
 Set stake 4" x 4" 18" in ground from which;
 a pine 12" in diameter bears N40°E - 139 lks
 a pine 12" in diameter bears N66½°W - 89 lks
 raised mound of rock

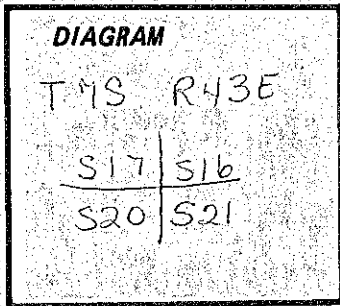

Description of corner evidence found:

Found mound of stone. No evidence of stake
 Found:
 14" ponderosa pine - N64°W - 89 lks - (dead & down)
 scribed "S 17"
 24" ponderosa pine - N48°E - 139 lks - scribing visible
 but not readable in rotten face

Description of monument and accessories established to perpetuate the original location of this corner:

Set 2½" x 30" aluminum pipe with 3¼" aluminum cap 8" in ground to bedrock, in large mound of stone, marked:

Bearing trees:


- 8" ponderosa pine - N36°W - 62.9 ft. - scribed "T7S R43E S17" in upper blaze and "BT" and brass tag stamped RLS 1664 in lower blaze
- 17" ponderosa pine - N19½°E - 110.4 ft. - scribed "T7S R43E S16" in upper blaze and "BT" and brass tag stamped RLS 1664 in lower blaze
- 2½ ft. x 2 ft. stone mound - S67°W - 7.5 ft.
- 3½ ft. x 2 ft. stone mound - S28°E - 6.2 ft.

Compass declination 23° East

Note:

I set steel fence post at corner location with USFS Attention sign placed USFS bearing tree signs on all bearing trees and painted red band on smooth bark at breast height on all bearing trees.

I hereby certify the above corner location was perpetuated as herein described in August 1981.

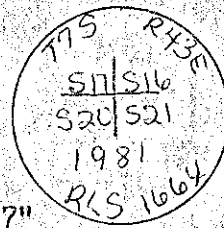

Terry Butler Terry Butler, Witness

Frank Vaughn Frank Vaughn, Witness

REGISTERED
 PROFESSIONAL
 LAND SURVEYOR

Carl E. Sundet
 OREGON
 JULY 14, 1978
 CARL E. SUNDET
 1664

Office of..... County of.....
 State of....., I hereby certify that the within instrument was filed in this office
 for record on the..... day of....., 19.....
 by.....
 (COUNTY OFFICIAL) (DEPUTY)

FILED OCT 22, 1981
 BAKER COUNTY SURVEYOR
 SURVEY NO. 7-43-20