


CERTIFIED RECORD OF LAND CORNER MONUMENTATION

History of original corner establishment:

Corner originally established by W. Barr under contract #388, dated May 7, 1881
Set basalt stone 16" x 10" x 10" from which;
a pine 16" in diameter bears S35 1/2° W - 140 lks
a pine 16" in diameter bears N37° E - 132 lks

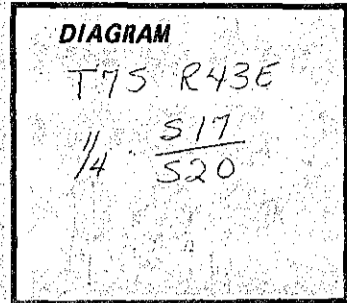


Description of corner evidence found:

Found:
29" ponderosa pine - N37° E - 132 lks - scribed "1/4 S" in open face. Alive. BT blaze grown over
No evidence of original stone.

Description of monument and accessories established to perpetuate the original location of this corner:

Set 2 1/2" x 30" aluminum pipe with 3 1/4" aluminum cap 24" in ground in mound of stone, marked:

Bearing trees:
17" ponderosa pine - S62 1/2° W - 28.1 ft. - scribed "1/4 S20" in upper blaze and "BT" and brass tag stamped RLS 1664 in lower blaze

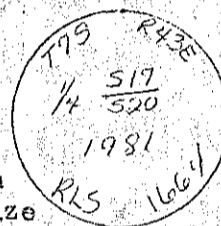

Compass declination 22° East

Note:

I set steel fence posts at corner with USFS Attention sign, placed USFS bearing tree signs on all bearing trees and painted red band on smooth bark at breast height on all bearing trees.

I hereby certify the above corner location was perpetuated as herein described in August 1981.

REGISTERED
PROFESSIONAL
LAND SURVEYOR

Carl E. Sundet

OREGON
JULY 14, 1978
CARL E. SUNDET
1664

Terry Butler Terry Butler, Witness

Frank Vaughn Frank Vaughn, Witness

Office of..... County of.....
State of..... I hereby certify that the within instrument was filed in this office
for record on the..... day of....., 19.....
..... by
(COUNTY OFFICIAL) (DEPUTY)

Form R6-7100-57 (9/71)

FILED OCT 22, 1981
BAKER COUNTY SURVEYOR
SURVEY NO. 7-43-22

☆ GPO-798-276