


CERTIFIED RECORD OF LAND CORNER MONUMENTATION

History of original corner establishment:

Corner originally established by W. Barr under contract #388 dated May 7, 1881  
Set 4" x 4" stake 18" in ground from which;  
a pine 30" in diameter bears N30°W - 80 lks  
a pine 20" in diameter bears S20°E - 65 lks

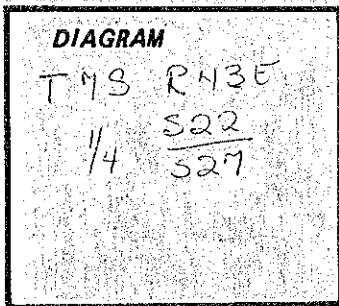

Description of corner evidence found:


Found:

23" ponderosa pine - S20°E - 123 lks. - (snag) - scribed "1/4 S"  
24" ponderosa pine stump - N30°W - 80 lks. - scribed "E"

No evidence of original stake.

Description of monument and accessories I established to perpetuate the original location of this corner:

Set 2 1/2" x 30" aluminum pipe with 3 1/4" aluminum cap 26" in ground in mound of stone. marked:

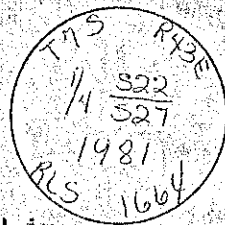

Bearing trees:

12" ponderosa pine - N79 1/2° E - 44.0 ft. - scribed "1/4 S22" in upper blaze and "E" and brass tag stamped RLS 1664 in lower blaze.  
13" ponderosa pine - S45° E - 54.8 ft. - scribed "1/4 S27" in upper blaze and "E" and brass tag stamped RLS 1664 in lower blaze.

Compass declination 21 1/4° East.

Note:

I set steel fence post at corner with USFS Attention sign, placed USFS bearing tree signs on all bearing trees and painted red band on smooth bark at breast height on all bearing trees.

Terry Butler Terry Butler, Witness

Frank Vaughn Frank Vaughn, Witness

REGISTERED PROFESSIONAL LAND SURVEYOR

Carl E. Sundet

OREGON JULY 14, 1978 CARL E. SUNDET 1664

Office of..... County of.....  
State of..... I hereby certify that the within instrument was filed in this office  
for record on the..... day of....., 19.....  
..... by .....

(COUNTY OFFICIAL)

(DEPUTY)

Form R6-7100-57 (9/71)

FILED Oct 22, 1981

BAKER COUNTY SURVEYOR  
SURVEY NO. 7-43-23