


CERTIFIED RECORD OF LAND CORNER MONUMENTATION

History of original corner establishment:

Corner originally established by W. Earr under contract # 388, dated 5/7/1881
Set 4' x 4" stake 18" in ground from which;
a fir 20" in diameter bears N85°E - 208 lks
a pine 15" in diameter bears S82½°E - 224 lks

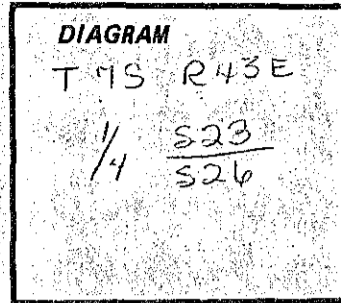

Description of corner evidence found:

Found:

30" douglas fir - N85°E - 208 lks - scribed "BT" (stump)
Could not verify other BT

No evidence of original stake.

Description of monument and accessories established to perpetuate the original location of this corner:

Set 2½" x 30" aluminum pipe with ¾" aluminum cap 26" in ground in mound of stone, marked:

Bearing trees:

7" douglas fir - N26½°E - 74.4 ft. - scribed "¼ S23" in upper blaze and "BT" and brass tag stamped RLS 1664 in lower blaze.

11" douglas fir - S81°E - 10.3 ft. - scribed "¼ S26" in upper blaze and "BT" and brass tag stamped RLS 1664 in lower blaze.

Compass declination 21° East

Note:

I set steel fence post at corner with USFS Attention sign, placed USFS bearing tree signs on all bearing trees and painted red band on smooth bark at breast height on all bearing trees.

I hereby certify the above corner location eas perpetuated as herein described in August 1981.



REGISTERED
PROFESSIONAL
LAND SURVEYOR

Carl E. Sundet

OREGON
JULY 14, 1978
CARL E. SUNDET
1664

Terry Butler Terry Butler, Witness

Frank Vaughn Frank Vaughn, Witness

Office of..... County of.....
State of..... I hereby certify that the within instrument was filed in this office
for record on the..... day of....., 19.....

..... by
(COUNTY OFFICIAL) (DEPUTY)

Form R6-7100-57 (9/71)

FILED Oct 22, 1981
BAKER COUNTY SURVEYOR
SURVEY NO. 7-43-26

☆ GPO-798-276