


CERTIFIED RECORD OF LAND CORNER MONUMENTATION

History of original corner establishment:

Corner originally established by W. Barr under contract #388, dated May 7, 1881.

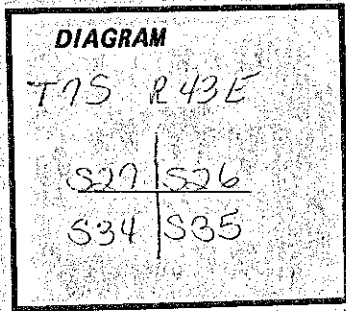

Set basalt rock 16"x12"x6" from which;
 a pine 36" diameter bears S 46° W 164 lks
 a pine 36" diameter bears N 11° W 275 lks
 a pine 14" diameter bears N 67½° E 146 lks

Description of corner evidence found:


Found 16" x 12" x 6" stone with no marks visible.

Found;

- 36" ponderosa pine - alive and healed face - N70°E - 146 lks
- 41" ponderosa pine - S47½°W - 164 lks - scribed "S34" "BT" stump partly decayed
- 26" ponderosa pine - N07°W - 275 lks - dead, down and rotten scribing under tree

Description of monument and accessories established to perpetuate the original location of this corner:

Set 2½" x 30" aluminum pipe with ¾" aluminum cap 24" in ground in mound of stone, marked;
 Buried original stone alongside pipe.

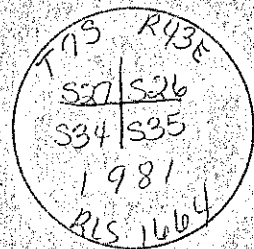

Bearing trees;

- 12" ponderosa pine - N77½° W - 8.5 ft. - scribed "T7S R43E S27" in upper blaze and "BT" and brass tag stamped RLS 1664 in lower blaze
- 10" ponderosa pine - N54½° E - 59.9 ft. - scribed "T7S R43E S26" in upper blaze and "BT" and brass tag stamped RLS 1664 in lower blaze
- 13" ponderosa pine - S12½° W - 57.3 ft. - scribed "T7S R43E S34" in upper blaze and "BT" and brass tag stamped RLS 1664 in lower blaze
- 11" ponderosa pine - S56° E - 43.9 ft. - scribed "T7S R43E S35" in upper blaze and "BT" and brass tag stamped RLS 1664 in lower blaze

Compass declination 21° East

Note:

I set steel fence post at corner with USFS attention sign, placed USFS bearing tree signs on all bearing trees and painted red band on smoothed bark at breast height on all bearing trees.

I hereby certify the above corner location was perpetuated as herein described in August 1981.

Terry Butler Terry Butler, Witness
Frank Vaughn Frank Vaughn, Witness



Office of..... County of.....
 State of..... I hereby certify that the within instrument was filed in this office
 for record on the..... day of..... 19.....
 by.....
 (COUNTY OFFICIAL) (DEPUTY)