


CERTIFIED RECORD OF LAND CORNER MONUMENTATION

History of original corner establishment:

Original corner established by W. Barr under contract #388, dated May 7, 1881.

Set basalt rock 12"x8"x6" from which;  
a pine 30" diameter bears N 45° E 93 lks  
a pine 14" diameter bears S 58° W 81 lks

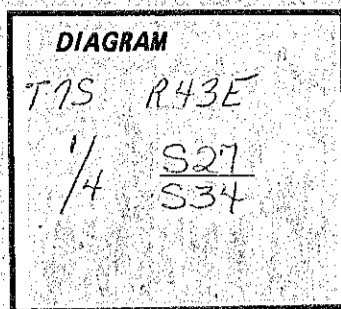

Description of corner evidence found:

Found 12" x 8" x 6" stone marked 1/4 on north face.

Found;

22" ponderosa pine - broken snag - S56° E - 81 lks  
scribed "1/4 S" - lower blaze grown over  
ponderosa pine stump - N45° E - 93 lks - decayed  
no scribing visible

Description of monument and accessories established to perpetuate the original location of this corner:

Set 2 1/2" x 30" aluminum pipe with 3 1/4" aluminum cap 26" in ground in mound of stone, marked;  
Buried original stone alongside pipe.



Bearing trees;

7" ponderosa pine - N14° E - 17.1 ft. - scribed "1/4 S27" in upper blaze and "BT" and brass tag stamped RLS 1664 in lower blaze.  
15" ponderosa pine - S13° E - 33.1 ft. - scribed "1/4 S34" in upper blaze and "BT" and brass tag stamped RLS 1664 in lower blaze

Compass declination 21° East

Note:

I set steel fence post at corner with USFS attention sign, placed USFS bearing tree signs on all bearing trees and painted red band on smoothed bark at breast height on all bearing trees.

I hereby certify the above corner location was perpetuated as herein described in August 1981.

Terry Butler, Witness

Frank Vaughn, Witness

REGISTERED PROFESSIONAL LAND SURVEYOR

Carl E. Sundet

OREGON JULY 14, 1978 CARL E. SUNDET 1664

Office of..... County of.....

State of....., I hereby certify that the within instrument was filed in this office

for record on the..... day of....., 19.....

..... by .....

(COUNTY OFFICIAL)

(DEPUTY)

Form R6-7100-57 (9/71)

FILED Oct 22, 1981 BAKER COUNTY SURVEYOR SURVEY NO. 7-43-31

GPO-798-276