


CERTIFIED RECORD OF LAND CORNER MONUMENTATION

History of original corner establishment:

Corner originally established by W. Barr under contract #388, dated May 7, 1881.

Set 14"x10"x5" stone from which;
a pine 30" diameter bears N 32° E 100 links
a pine 24" diameter bears S 32° W 42 links

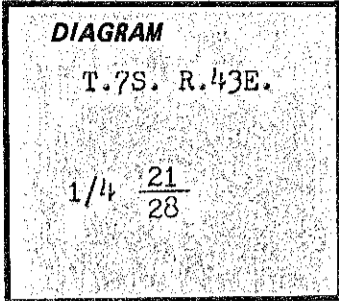

Description of corner evidence found:

No evidence of stone. Corner falls approx. 3 ft. from fence jack.

Bearing trees

24" P.Pine stump, N 32° E 100 links, scribed "BT"
24" P.Pine, dead and down, S 32° W 42 links, tree lying on chopped open face, some visible scribing.

Description of monument and accessories established to perpetuate the original location of this corner:

Set 2 1/2"x30" aluminum pipe with 3 1/4" aluminum cap 24" in ground in mound of stone. Cap marked;

Bearing Trees

11" P.Pine bears N 59 1/2° E 38.1 ft., scribed "1/4 S21" in upper blaze and "BT" and brass tag stamped RLS 1664 in lower blaze.
11" P.Pine bears S 30° E 32.7 Ft., scribed "1/4 S28" in upper blaze and "BT" and brass tag stamped RLS 1664 in lower blaze.

Compass declination 20° 15' East.


Note:

I set steel fence post at corner with USFS attention sign, placed USFS bearing tree signs on all bearing trees, and painted red band on smooth bark at breast height on all bearing trees.

I hereby certify the above corner was perpetuated as herein described in August 1981.

Terry Butler Terry Butler, Witness

Frank Vaughn Frank Vaughn, Witness

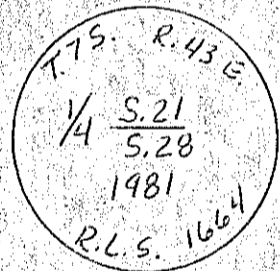

REGISTERED
PROFESSIONAL
LAND SURVEYOR

Carl E. Sundet

OREGON
JULY 14, 1978
CARL E. SUNDET
1664

Office of..... County of.....
State of..... I hereby certify that the within instrument was filed in this office
for record on the..... day of....., 19.....
..... by.....
(COUNTY OFFICIAL) (DEPUTY)

Form R6-7100-57 (9/71)

FILED OCT 27, 1981
BAKER COUNTY SURVEYOR
SURVEY NO. 7-43-33