


CERTIFIED RECORD OF LAND CORNER MONUMENTATION

History of original corner establishment:

Corner originally established by W. Barr under contract #388, dated May 7, 1881.

Set volcanic rock 12"x8"x6" from which;
a pine 48" diameter bears S 41° E 78 lks
a pine 36" diameter bears N 20° W 49 lks

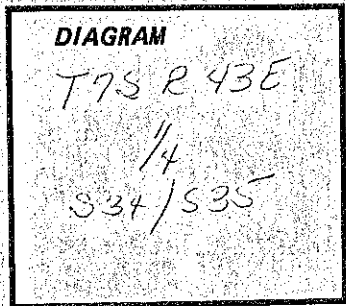

Description of corner evidence found:


12" x 8" x 6" stone marked 1/4 on west face in an undisturbed mound of stone.

Found:

45" ponderosa pine stump - S37°E - 78 lks - rotten and partly burned - no visible scribing
No evidence of NW BP. Area is in old burn.

Description of monument and accessories established to perpetuate the original location of this corner:

Set 2 1/2" x 30" aluminum pipe with 3 1/4" aluminum cap 24" in ground in mound of stone, marked;
Buried original stone alongside of pipe.

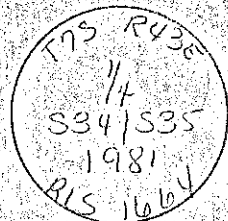

Bearing trees;

12" ponderosa pine - N10 1/2° W - 70.1 ft - scribed "1/4 S34" in upper blaze and "BT" and brass tag stamped RLS 1664 in lower blaze
14" ponderosa pine - N12° E - 107.4 ft - scribed "1/4 S35" in upper blaze and "BT" and brass tag stamped RLS 1664 in lower blaze

Compass declination 21° 15' East

REGISTERED
PROFESSIONAL
LAND SURVEYOR

Note:

I set steel fence post at corner with USFS attention sign, placed USFS bearing tree signs on all bearing trees and painted red band on smoothed bark at breast height on all bearing trees.

Carl E. Sundet
OREGON
JULY 14, 1978
CARL E. SUNDET
1664

I hereby certify the above corner location was perpetuated as herein described in August 1981.

Terry Butler Terry Butler, Witness
Frank Vaughn Frank Vaughn, Witness

Office of..... County of.....
State of..... I hereby certify that the within instrument was filed in this office
for record on the..... day of....., 19.....
..... by

(COUNTY OFFICIAL)

(DEPUTY)

Form R6-7100-57 (9/71)

FILED Oct 22, 1981
BAKER COUNTY SURVEYOR
SURVEY NO. 7-43-35