


CERTIFIED RECORD OF LAND CORNER MONUMENTATION

History of original corner establishment:

Original corner established by W. Barr under contract #388, dated May 7, 1881.

Set 4 ft. x 4 in. stake 18" in ground from which;  
a fir 10" diameter bears S 12° E 26 lks  
a cottonwood 8" diameter bears N 55° E 33 lks

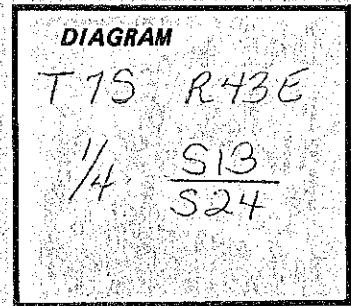

Description of corner evidence found:

No evidence of stake.

Found;

25" douglas fir - S12°E - 26 lks - alive and grown over  
opened lower blaze and found "BT" scribing  
Aspen BT gone


Description of monument and accessories I established to perpetuate the original location of this corner:

Set 2 1/2" x 30" aluminum pipe with 3 1/4" aluminum cap 24" in ground in mound of stone marked;

Bearing trees;

8" white fir - N68°E - 37.9 ft. - scribed "1/4 S13" in upper blaze and "BT" and brass tag stamped RLS 1664 in lower blaze  
16" ponderosa pine - S33 1/2°W - 64.5 ft. - scribed "1/4 S24" in upper blaze and "BT" and brass tag stamped RLS 1664 in lower blaze

Compass declination 21° 15' East

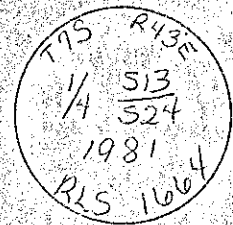

Note:

I set steel fence post at corner with USFS attention sign, placed USFS bearing tree signs on all bearing trees and painted red band on smoothed bark at breast height on all bearing trees.

I hereby certify the above corner location was perpetuated as herein described in August 1981.

Terry Butler Terry Butler, Witness

Frank Vaughn Frank Vaughn, Witness

REGISTERED  
PROFESSIONAL  
LAND SURVEYOR

*Carl E. Sundet*

OREGON  
JULY 14, 1978  
CARL E. SUNDET  
1664

Office of..... County of.....

State of....., I hereby certify that the within instrument was filed in this office

for record on the..... day of....., 19.....

..... by.....  
(COUNTY OFFICIAL) (DEPUTY)

Form R6-7100-57 (9/71)

FILED Oct 27, 1981  
BAKER COUNTY SURVEYOR  
SURVEY NO. 7-43-36