


CERTIFIED RECORD OF LAND CORNER MONUMENTATION

History of original corner establishment:

Original corner established by W. Barr under contract #388, dated May 7, 1881.

Set 14"x8"x6" stone from which;
 a cottonwood 3" diameter bears N 44° E-14 lks
 a cottonwood 3" diameter bears N 33° W-15 lks
 a fir 24" diameter bears S 29° E 75 lks
 a fir 20" diameter bears S 62° W 107 lks

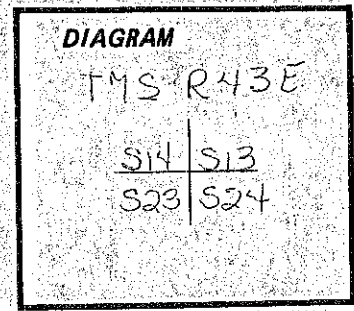

Description of corner evidence found:


Found 14" x 8" x 6" stone with 3 notches south and 1 groove east.

Found:

 fir stump - S62°W - 107 lks - scribed "BT"
 Both aspen BT's are gone and SE fir BT would have fallen in road.

Description of monument and accessories established to perpetuate the original location of this corner:

Set 2½" x 30" aluminum pipe with ¾" aluminum cap 24" in ground in mound of stone, marked;
 Buried original stone alongside pipe.

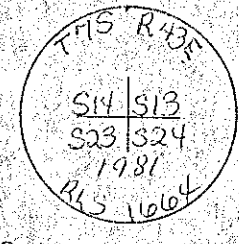

Bearing trees;

 10" douglas fir - N25½° E - 28.2 ft. - scribed "T7S R43E S13" in upper blaze and "BT" and brass tag stamped RLS 1664 in lower blaze
 9" aspen - S70° E - 15.2 ft. - scribed "T7S R43E S24" in upper blaze and "BT" and brass tag stamped RLS 1664 in lower blaze
 7" white fir - S07° W - 112.9 ft. - scribed "T7S R43E S23" in upper blaze and "BT" and brass tag stamped RLS 1664 in lower blaze
 11" ponderosa pine - N88° W - 69.5 ft. - scribed "T7S R43E S14" in upper blaze and "BT" and brass tag stamped RLS 1664 in lower blaze

Compass declination 21° East

Note:

I set steel fence post at corner with USFS attention sign, placed USFS bearing tree signs on all bearing trees and painted red band on smoothed bark at breast height on all bearing trees.

REGISTERED
PROFESSIONAL
LAND SURVEYOR

Carl E. Sundet

CREATED
JULY 14, 1978
CARL E. SUNDET
T.E.S.

I hereby certify the above corner location was perpetuated as herein described in August 1981

Terry Butler Terry Butler, Witness

Frank Vaughn Frank Vaughn, Witness

Office of..... County of.....

State of..... I hereby certify that the within instrument was filed in this office

for record on the..... day of....., 19.....

..... by
 (COUNTY OFFICIAL) (DEPUTY)