

CERTIFIED RECORD OF LAND CORNER MONUMENTATION

History of original corner establishment:

Corner originally established by W. Earr under contract #388, dated May 7, 1881.

Set post 4 ft. long and 4 inches in diameter 18 inches in ground from which;

- a pine 36" diameter bears N 47° W 32 lks
- a fir 12" diameter bears S 56° W 76 lks
- a pine 30" diameter bears S 27½° E 77 lks
- a pine 8" diameter bears N 45½° E 127 lks

Corner re-established by BIM in 1974. Set an iron post, 28" long, 2½" diameter, 22" in the ground, with brass cap marked;


- From which; a fir, 9" in diameter bears N 66 E 15 links distance, marked "T7SR44ES18"BT"
- a fir, 13" in diameter bears S 23 E 22 links distance, marked "T7SR44ES19"BT"
- a ponderosa pine, 12" in diameter bears N 20 W 65 links distance, marked "T7SR43ES13"BT"

Description of corner evidence found:

Found no evidence of BIM Brass Cap set in 1974.

Found;

- 9" Fir N 66° E 15 lks. Partly healed face.
- 13" Fir S 23° E 22 lks. Partly healed face.
- 12" Ponderosa Pine N 20° W 65 lks. Partly healed face.
- 34" Ponderosa Pine N 48° E 127 lks. Healed face.
- 34" Fir S 56° W 76 lks. Healed face.

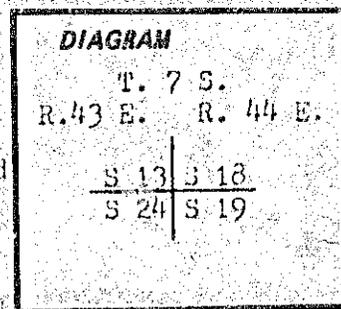

T 7 S
R 43 E R 44 E

S 13	S 18
S 24	S 19


1974

Description of monument and accessories established to perpetuate the original location of this corner:

Set 2½" x 30" aluminum cap with ¾" aluminum cap, 25" in ground in mound of stone. Marked;

No new bearing trees.

Compass declination 20° East

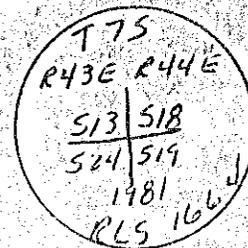

Note:

I set steel fence post at corner with USFS Attention sign, placed USFS bearing tree signs on all bearing trees and painted red band on smoothed bark at breast height on all bearing trees.

I hereby certify the above corner location was perpetuated as herein described in September 1981.

Terry Butler Terry Butler, Witness

Frank Vaughn Frank Vaughn, Witness

REGISTERED
PROFESSIONAL
LAND SURVEYOR

OREGON
JULY 14, 1978
CARL E. SUNDET
1664

Office of..... County of.....
State of....., I hereby certify that the within instrument was filed in this office
for record on the..... day of....., 19.....

..... by
(COUNTY OFFICIAL) (DEPUTY)